



FALL CREEK REGIONAL WASTE DISTRICT

Box 44, Pendleton, Indiana 46064

22-27020.00

Steven Voss

Nº 001983

APPLICATION FOR SEWER PERMIT

Permit No. \_\_\_\_\_ Date 1/4/94  
Permit Void 90 days from Date of Issuance  
Owner Name Eric Ayers  
Property Address 1820 W. Deer Crossing  
Lot # 23 P.O. Box \_\_\_\_\_  
Town Pendleton, IN Zip Code 46064  
Phone \_\_\_\_\_ Water Meter \_\_\_\_\_"  
\$ 350.00 Tap on Fee Paid availability fee 2000.00  
\$ 25.00 Inspection fee paid inter. fee 1243.50

Application is hereby made for connection to the Fall Creek Regional Waste District Sewer System for the above listed property - Permit Type: Residential ☒, Commercial \_\_\_\_\_, Industrial \_\_\_\_\_, or Governmental/Institutional \_\_\_\_\_. User Information \_\_\_\_\_.

All workmanship and materials shall conform to the standards of the District Ordinance as described in Ordinance 84-2 and 84-3 as amended. Acceptance and approval must be made by the District inspector or his duly authorized representative before backfilling and final connection is made to the main sewer lines. Any violation of applicable regulations will cause all lines and appurtenances in violation to be removed and replaced at the owners expense.

The Fall Creek Regional Waste District is responsible for the inspection, approval of materials, and installation techniques only. All costs for materials and installation and any liabilities resulting from same is the sole responsibility of the property owner.

I have read and fully understand the above provisions and agree to comply by said provisions.

P. Eric Ayers  
APPLICANT(S) SIGNATURE

\*\*\*\*\*


INSPECTOR [Signature]

Date inspected 1-12-94 Approved ☒ Rejected \_\_\_\_\_

Reason for rejection \_\_\_\_\_

Date reinspected \_\_\_\_\_ Approved \_\_\_\_\_ Rejected \_\_\_\_\_

Notes:  
Size Pipe 6"  
Type Pipe PVC  
Basement Yes \_\_\_\_\_ No \_\_\_\_\_  
Sump Pump Yes ☒ No \_\_\_\_\_  
Downspout to Ground Yes ☒ No \_\_\_\_\_  
Septic Tank Pumped & filled Yes \_\_\_\_\_ No \_\_\_\_\_  
Contractor Tri-Co. Plumbing  
Special Conditions (Tom Davis Exc.)

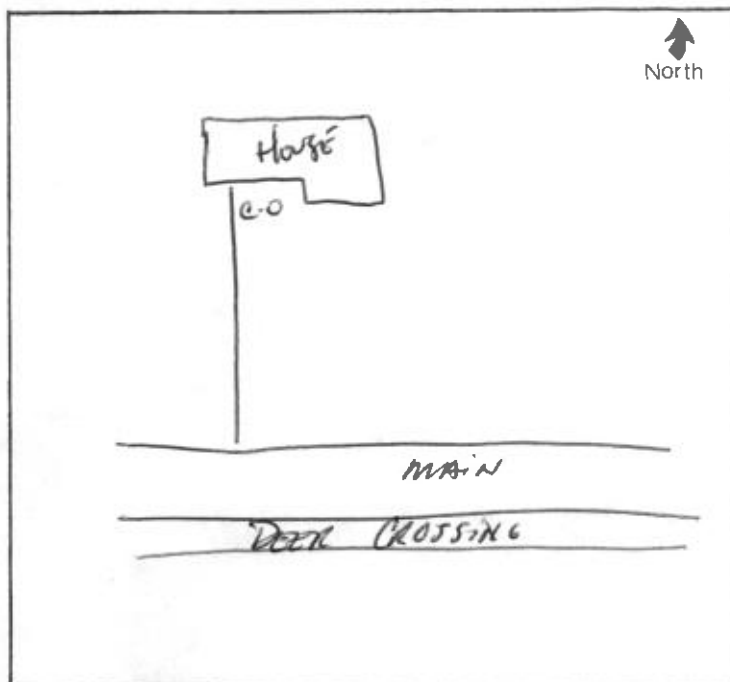



FALL CREEK REGIONAL WASTE DISTRICT

Box 22 Frederick, Idaho 86004

23-2725 04

NO 001383

Handwritten notes and signatures, including "John" and "John Jones".

Handwritten notes and signatures, including "John Jones" and "John Jones".

