



FALL CREEK REGIONAL WASTE DISTRICT

9378 S. 650 West PO Box 59
Pendleton, IN 46064-0059 778-7544

add order
on file

22-28385.00

APPLICATION FOR SEWER PERMIT

Nº 2027

Date 3-23-94

Permit Void 90 days from Date of Issuance

Owner Name ERIC HANES

Property Address 1861 RACCOON WAY

Lot # 29 P.O. Box _____

Town Pendleton, IN Zip Code 46064

Phone _____ City Water _____ Well _____

\$ 350.00 Tap on Fee Paid Avail. 2000.00 4/13/94

25.00 Inspection fee paid Interior 1243.50 4/13/94

EXTRA INSP 3-26-94
for SAT.

Application is hereby made for connection to the Fall Creek Regional Waste District Sewer System for the above listed property - Permit Type: Residential ☒, Commercial _____, Industrial _____, or Governmental/Institutional _____. User Information _____.

All workmanship and materials shall conform to the standards of the District Ordinance as described in Ordinance 84-2 and 84-3 as amended. Acceptance and approval must be made by the District inspector or his duly authorized representative before backfilling and final connection is made to the main sewer lines. Any violation of applicable regulations will cause all lines and appurtenances in violation to be removed and replaced at the owners expense.

The Fall Creek Regional Waste District is responsible for the inspection, approval of materials, and installation techniques only. All costs for materials and installation and any liabilities resulting from same is the sole responsibility of the property owner.

I have read and fully understand the above provisions and agree to comply by said provisions.

E. G. Z

APPLICANT(S) SIGNATURE

INSPECTOR B

Date inspected 3-26-94 Approved ☒ Rejected _____

Reason for rejection _____

Date reinspected _____ Approved _____ Rejected _____

Notes:

Size Pipe 6"

Type Pipe PVC

Basement Yes ☒ No _____

Sump Pump Yes ☒ No _____

Downspout to Ground Yes ☒ No _____


Septic Tank Pumped & filled Yes ☒ No _____

Contractor Burkett - BC Plumbing

Special Conditions NEW HOME

Existing Home _____

New Construction ☒

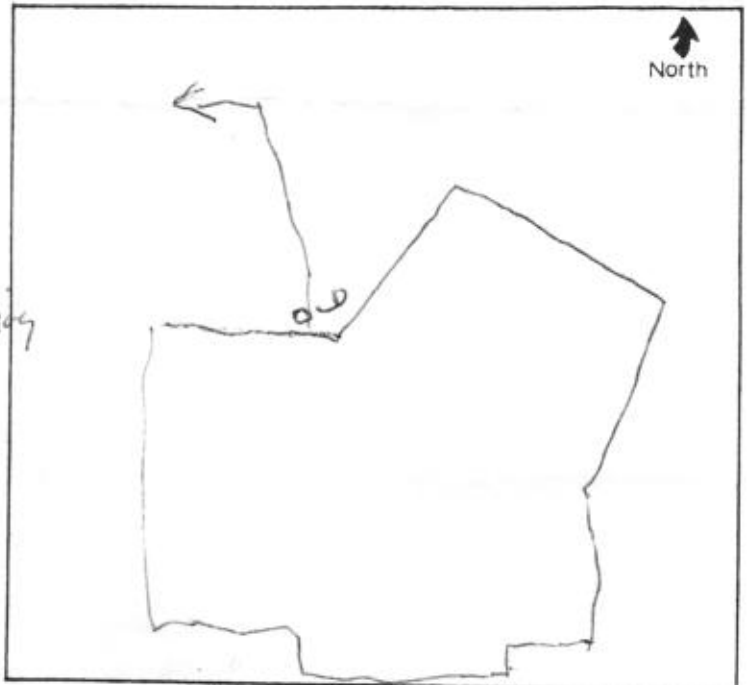

Handwritten notes at top left.



PAUL CREEK REGIONAL WASTE DISTRICT
1211 N. 10th St. Suite 100
Billings, MT 59102
Phone: (406) 245-1111

IN 2021

3-23-21

ERIC HANES

Pay com 1/1/21

placed


April 2020.00

301.00

30.00

DATE: 4/1/21
TO: ERIC HANES
FROM: PAUL CREEK REGIONAL WASTE DISTRICT
AMOUNT: \$331.00
REASON: PAYROLL
APPROVED: [Signature]
DATE: 4/1/21

301.00

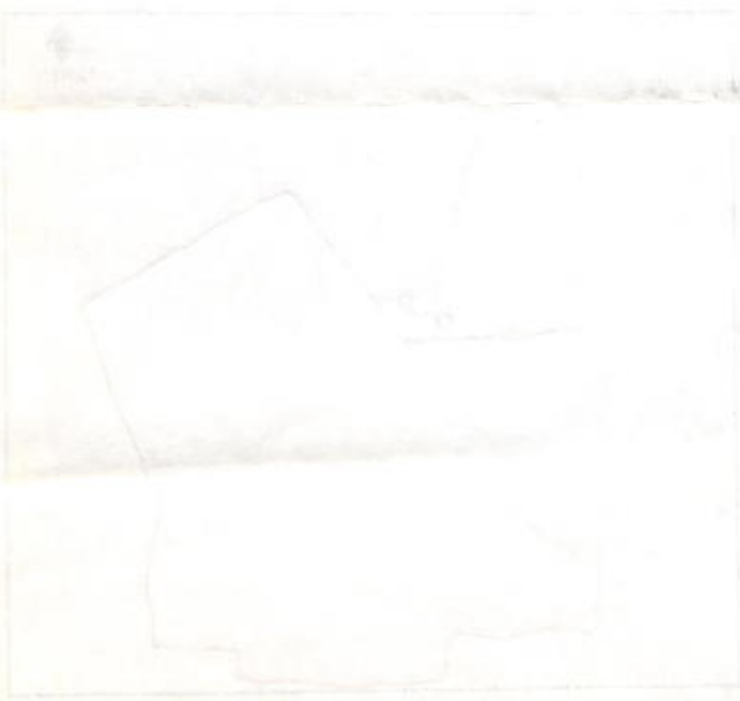

4-12-1994

Fall Creek Regional Waste District
P.O. Box 59
9378 S. 650 West
Pendleton, In, 46064

Please find enclosed the check of \$3,243.50 to pay the fees due your company. This is for Eric A. & Lynnette K Hanes 6824 Delaware, Anderson, In, 46013. Our lot is lot 29 Hickory Hills-East Subdivision, Pendleton. If you have any questions please give me a call at 317-266-6367 during the day and 317-622-6024 in the evening.

Sincerely,

Lynnette K. Hanes
Lynnette K. Hanes

*6824 Delaware
Anderson, In 46013*

PREPARED BY STATE BOARD OF ACCOUNTS BOYCE FORMS SYSTEMS, MUNCIE, IN.

GENERAL FORM NO. 352

RECEIPT

FALL CREEK REGIONAL WASTE DISTRICT
P.O. BOX 59, CO. RD. 650 WEST

№ 4319

gen FUND
PENDLETON, IND. 46064, *3/28* 19 *94*

RECEIVED FROM *B.C. Plumbing* \$ *25.00*

THE SUM OF *Twenty five & 00/100* DOLLARS

ON ACCOUNT OF *extra inspection fee*
lot 29, Raccoon Way, Hickory Hills East

PAID BY: CASH ☐ CHECK ☒ M.O. ☐ *485*

Debbie Wilson

AUTHORIZED SIGNATURE