



FALL CREEK REGIONAL WASTE DISTRICT

Box 44, Pendleton, Indiana 46064

add order on file

APPLICATION FOR SEWER PERMIT

Nº 001970

Permit No. _____ Date 12/1/93

Permit Void 90 days from Date of Issuance

Owner Name Jeff Neal (sold to Tom Stuart 12/3/93)Property Address 1872 W Huntsville Rd

Lot # _____ P.O. Box _____

Town Pendleton, IN Zip Code 46064

Phone _____ Water Meter _____

\$ 700.00 Tap on Fee Paid Availability fee 2000.00\$ 25.00 Inspection fee paid

Application is hereby made for connection to the Fall Creek Regional Waste District Sewer System for the above listed property - Permit Type: Residential ☒, Commercial _____, Industrial _____, or Governmental/Institutional _____. User Information _____.

All workmanship and materials shall conform to the standards of the District Ordinance as described in Ordinance 84-2 and 84-3 as amended. Acceptance and approval must be made by the District inspector or his duly authorized representative before backfilling and final connection is made to the main sewer lines. Any violation of applicable regulations will cause all lines and appurtenances in violation to be removed and replaced at the owners expense.

The Fall Creek Regional Waste District is responsible for the inspection, approval of materials, and installation techniques only. All costs for materials and installation and any liabilities resulting from same is the sole responsibility of the property owner.

I have read and fully understand the above provisions and agree to comply by said provisions.


X Jeff Neal APPLICANT(S) SIGNATURE

Date inspected 12/2/93 INSPECTOR Tim Approved ☒ Rejected _____

Reason for rejection _____

Date reinspected _____ Approved _____ Rejected _____

Notes:
 Size Pipe 6"
 Type Pipe SDR 350-RNH
 Basement Yes ☒ No ☒
 Sump Pump Yes ☒ No ☒
 Downspout to Ground Yes ☒ No ☒
 Septic Tank Pumped & filled Yes ☒ No ☒
 Contractor Brad McKinney
 Special Conditions 1st Home
Hooked up

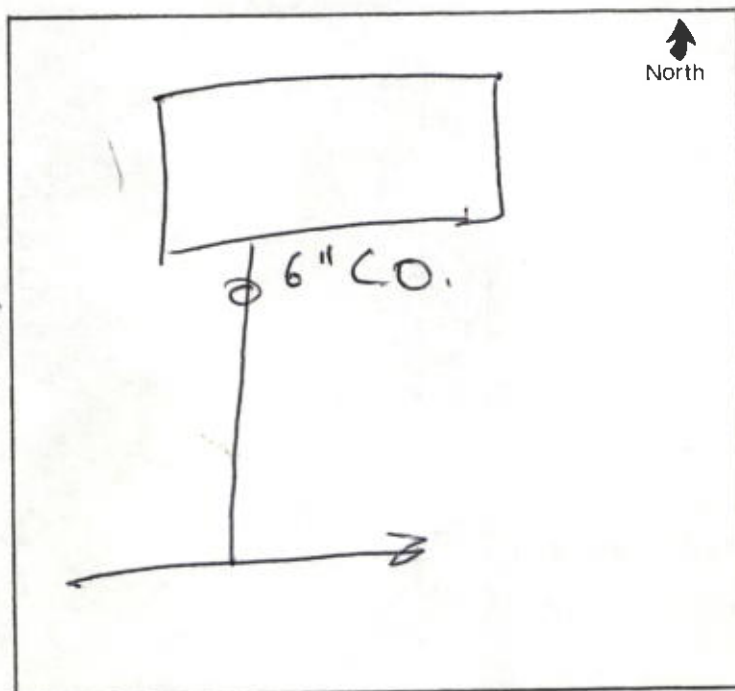

07 : Mr. Tom Stuart

1872 W. HUNTSVILLE ROAD

Pendleton, IN 46064

SUBJECT

Permit for Sewer

DATE

12/07/93

MESSAGE

Enclosed is a copy of the permit showing that the fees were paid for and the line was inspected. If you have any questions you can call us at 778-7544.

Sincerely,

SIGNED

Debbie Wilson

DATE

REPLY

SIGNED

Mr. Tom Stewart

1873 W. Hanesville Road

Hamlet, IN 46064

SUBJECT

Permit for Sewer

DATE

12/07/93

MESSAGE

Enclosed is a copy of the permit
showing that the fees were paid for and the
line was inspected. If you have any questions
you can call us at 778-7544.

Sincerely,

William H. Brown

SIGNED

DATE

REPLY

SIGNED

SENDER - RETAIN THIS COPY