



# FALL CREEK REGIONAL WASTE DISTRICT

9378 S. 650 West PO Box 59  
Pendleton, IN 46064-0059 778-7544

add order  
on file

## APPLICATION FOR SEWER PERMIT

No 2322

Date

11/28/95

4 2355

Permit Void 90 days from Date of Issuance

Owner Name

Hallmark Homes

Property Address

Lot # 10, Pines of Deerfield

P.O. Box

Town

IN Zip Code

Phone

City Water

Well

\$ 2700.00

Tap on Fee Paid

\$ 25.00

Inspection fee paid

Application is hereby made for connection to the Fall Creek Regional Waste District Sewer System for the above listed property - Permit Type: Residential ☒, Commercial ☐, Industrial ☐, or Governmental/Institutional ☐. User Information

All workmanship and materials shall conform to the standards of the District Ordinance as described in Ordinance 84-2 and 84-3 as amended. Acceptance and approval must be made by the District inspector or his duly authorized representative before backfilling and final connection is made to the main sewer lines. Any violation of applicable regulations will cause all lines and appurtenances in violation to be removed and replaced at the owners expense.

The Fall Creek Regional Waste District is responsible for the inspection, approval of materials, and installation techniques only. All costs for materials and installation and any liabilities resulting from same is the sole responsibility of the property owner.

I have read and fully understand the above provisions and agree to comply by said provisions.

APPLICANT(S) SIGNATURE

INSPECTOR

Dan

Date inspected

11-28-95

Approved

☒

Rejected

Reason for rejection

Date reinspected

Approved

Rejected

Notes:

Size Pipe

6"

Type Pipe

PVC

Basement Yes

☒

No

Sump Pump Yes

☒

No

Downspout to Ground Yes

☒

No

Septic Tank Pumped & filled Yes

No

Contractor


Mark Smith

Special Conditions

Existing Home

New Construction

☒

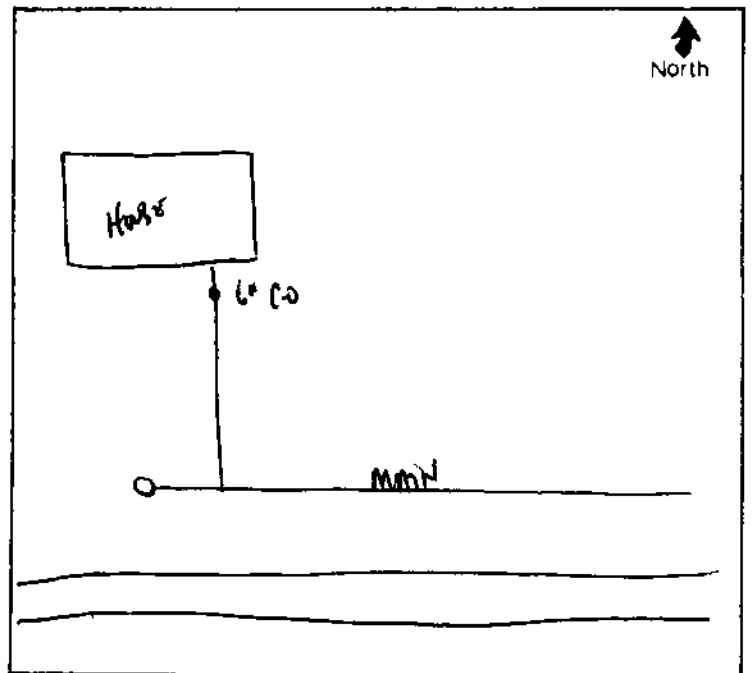

**HALLMARK HOMES, INC.**

PH 317-644-6566  
PO BOX 42  
PENDLETON, IN 46064-0042

71-553/749  
BRANCH 1

6949

PAY  
TO THE  
ORDER OF

Fall Creek Regional Waste

11.28 1995

\$2,725.00

Two Thousand, Seven Hundred twenty-five

DOLLARS



**Pendleton Banking  
Company**  
Member FDIC

FOR

Sewer Tap Fee - Bretts lot 10 Pines. Kevin L Porter

⑈006949⑈ ⑈074905539⑈



FALL CREEK REGIONAL WASTE DISTRICT

9378 S. 650 West PO Box 59  
Pendleton, IN 46064-0059 778-7544

778-8139

add order  
on file

13-31950.00

APPLICATION FOR SEWER PERMIT

No 2355

Date 4-8-96

Permit Void 90 days from Date of Issuance Hallmark  
Owner Name Heritage Homes Jim Butz  
Property Address 190 Blue Spruce Dr  
Lot # 10 - Pines at Deerfield P.O. Box \_\_\_\_\_  
Town Pendleton, IN Zip Code 46064  
Phone \_\_\_\_\_ City Water ☒ Well \_\_\_\_\_  
\$ 2700.00 Tap on Fee Paid XXXXXXXXXX  
\$ 25.00 Inspection fee paid cell # 2322

Application is hereby made for connection to the Fall Creek Regional Waste District Sewer System for the above listed property - Permit Type: Residential ☒, Commercial \_\_\_\_\_, Industrial \_\_\_\_\_, or Governmental/Institutional \_\_\_\_\_. User Information \_\_\_\_\_

All workmanship and materials shall conform to the standards of the District Ordinance as described in Ordinance 84-2 and 84-3 as amended. Acceptance and approval must be made by the District inspector or his duly authorized representative before backfilling and final connection is made to the main sewer lines. Any violation of applicable regulations will cause all lines and appurtenances in violation to be removed and replaced at the owners expense.

The Fall Creek Regional Waste District is responsible for the inspection, approval of materials, and installation techniques only. All costs for materials and installation and any liabilities resulting from same is the sole responsibility of the property owner.

I have read and fully understand the above provisions and agree to comply by said provisions.

APPLICANT(S) SIGNATURE

\*\*\*\*\*

INSPECTOR Jim

Date inspected 4-8-96 Approved ☒ Rejected \_\_\_\_\_

Reason for rejection \_\_\_\_\_

Date reinspected \_\_\_\_\_ Approved \_\_\_\_\_ Rejected \_\_\_\_\_

Notes:  
Size Pipe 6"  
Type Pipe SDR35  
Basement Yes ☒ No ☒  
Sump Pump Yes ☒ No ☒  
Downspout to Ground Yes ☒ No ☒  
Septic Tank Pumped & filled Yes ☒ No ☒  
Contractor G.R. Const.  
Special Conditions \_\_\_\_\_  
Existing Home \_\_\_\_\_  
New Construction ☒

