




Huntzinger Farms

Lot 88

6/14/21

~~1914 Cold Springs Dr.~~

1906 Cold Springs Dr.

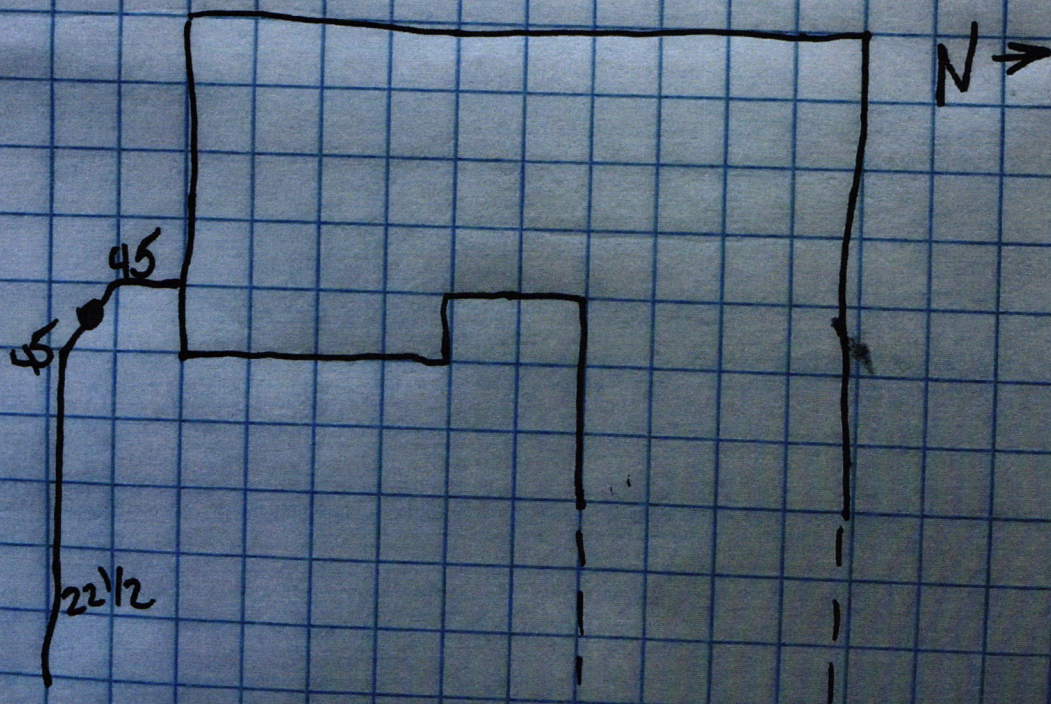

Huntzinger Farms



