



FALL CREEK REGIONAL WASTE DISTRICT

Box 44, Pendleton, Indiana 46064

22-28000.00

Nº 001996

APPLICATION FOR SEWER PERMIT

Permit No. \_\_\_\_\_ Date 2-7-94  
Permit Void 90 days from Date of Issuance  
Owner Name Mr. John L. Long  
Property Address 1917 W. Huntsville Rd  
Lot # \_\_\_\_\_ P.O. Box \_\_\_\_\_  
Town Pendleton, IN Zip Code 46064  
Phone 778-2747 Water Meter \_\_\_\_\_  
\$ 700.00 Tap on Fee Paid 2,000 pd  
\$ 25.00 Inspection fee paid

Application is hereby made for connection to the Fall Creek Regional Waste District Sewer System for the above listed property - Permit Type: Residential X, Commercial \_\_\_\_\_, Industrial \_\_\_\_\_, or Governmental/Institutional \_\_\_\_\_. User Information \_\_\_\_\_.

All workmanship and materials shall conform to the standards of the District Ordinance as described in Ordinance 84-2 and 84-3 as amended. Acceptance and approval must be made by the District inspector or his duly authorized representative before backfilling and final connection is made to the main sewer lines. Any violation of applicable regulations will cause all lines and appurtenances in violation to be removed and replaced at the owners expense.

The Fall Creek Regional Waste District is responsible for the inspection, approval of materials, and installation techniques only. All costs for materials and installation and any liabilities resulting from same is the sole responsibility of the property owner.

I have read and fully understand the above provisions and agree to comply by said provisions.


X John L. Long  
APPLICANT(S) SIGNATURE

\*\*\*\*\*

INSPECTOR Dan  
Date inspected 2-16-94 Approved ✓ Rejected \_\_\_\_\_  
Reason for rejection \_\_\_\_\_

Date reinspected \_\_\_\_\_ Approved \_\_\_\_\_ Rejected \_\_\_\_\_

Notes:  
Size Pipe 6"  
Type Pipe PVC  
Basement Yes ✓ No \_\_\_\_\_  
Sump Pump Yes \_\_\_\_\_ No ✓  
Downspout to Ground Yes ✓ No \_\_\_\_\_  
Septic Tank Pumped & filled Yes \_\_\_\_\_ No \_\_\_\_\_  
Contractor Stump Co  
Special Conditions \_\_\_\_\_

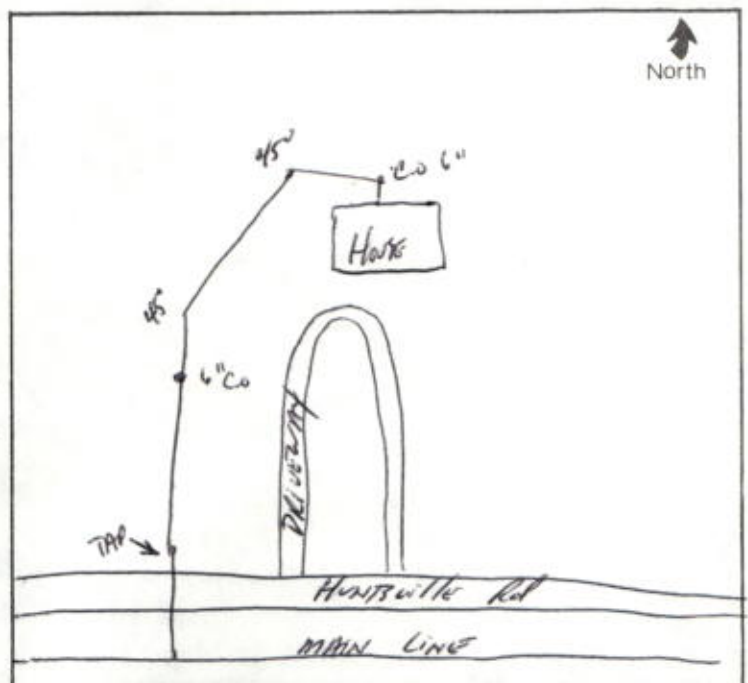



FALL CREEK REGIONAL WASTE DISTRICT

Box 44, Pendleton, Indiana 46054 219-286-0000

IN 001386

AT THE OFFICE OF THE DISTRICT ENGINEER

2-7-94

Permit No.

Permit Valid To: The term of this permit is

Mr. John L. Wood

1917 W. Huntville Rd

Lot #

4004

Pendleton

778-2777

Phone

700.00

Fee on Fee

2,000.00

25.00

Inspection Fee

Application is hereby made for a permit to install and operate a waste disposal system for the above listed property. Permit type: Residential ☒ Commercial ☐ Industrial ☐ Other ☐

All waste disposal systems shall conform to the standards of the District. The system shall be installed in accordance with the standards of the District. The system shall be installed in accordance with the standards of the District. The system shall be installed in accordance with the standards of the District.

The Fall Creek Regional Waste District is responsible for the proper operation of the system and for the maintenance of the system. The system shall be installed in accordance with the standards of the District. The system shall be installed in accordance with the standards of the District.

I have read and fully understand the District's regulations and rules. I agree to comply with all District regulations and rules. I agree to comply with all District regulations and rules.

X

Signature of Applicant

Signature of District Engineer

2/7/94

Date

Signature for Registration

Signature for Registration

Signature

Signature

NO

Signature for NO

Signature for NO

Signature for NO

Signature for NO

Signature

Signature

