



FALL CREEK REGIONAL WASTE DISTRICT

Box 44, Pendleton, Indiana 46064

add order on file

22-28100.00

Nº 001978

APPLICATION FOR SEWER PERMIT

Permit No. \_\_\_\_\_ Date 12/21/93  
Permit Void 90 days from Date of Issuance  
Owner Name Kenneth E & Brinda L. Robertson  
Property Address 1977 West Huntsville Rd  
Lot # \_\_\_\_\_ P.O. Box FE  
Town Pendleton, IN Zip Code 46064-9095  
Phone 317-778-8644 Water Meter \_\_\_\_\_"  
\$ 700.00 Tap on Fee Paid availability fee 2,000.00 3/9/94  
\$ 25.00 Inspection fee paid

Application is hereby made for connection to the Fall Creek Regional Waste District Sewer System for the above listed property - Permit Type: Residential ☒, Commercial \_\_\_\_\_, Industrial \_\_\_\_\_, or Governmental/Institutional \_\_\_\_\_. User Information \_\_\_\_\_.

All workmanship and materials shall conform to the standards of the District Ordinance as described in Ordinance 84-2 and 84-3 as amended. Acceptance and approval must be made by the District inspector or his duly authorized representative before backfilling and final connection is made to the main sewer lines. Any violation of applicable regulations will cause all lines and appurtenances in violation to be removed and replaced at the owners expense.

The Fall Creek Regional Waste District is responsible for the inspection, approval of materials, and installation techniques only. All costs for materials and installation and any liabilities resulting from same is the sole responsibility of the property owner.

I have read and fully understand the above provisions and agree to comply by said provisions.

X Kenneth E Robertson

APPLICANT(S) SIGNATURE

\*\*\*\*\*

INSPECTOR Don

Date inspected \_\_\_\_\_ Approved ☒ Rejected \_\_\_\_\_

Reason for rejection \_\_\_\_\_

Date reinspected \_\_\_\_\_ Approved \_\_\_\_\_ Rejected \_\_\_\_\_

Notes:

Size Pipe 6"

Type Pipe PVC

Basement Yes ☒ No \_\_\_\_\_


Sump Pump Yes \_\_\_\_\_ No ☒

Downspout to Ground Yes ☒ No \_\_\_\_\_


Septic Tank Pumped & filled Yes \_\_\_\_\_ No \_\_\_\_\_

Contractor BAKER Const.

Special Conditions \_\_\_\_\_

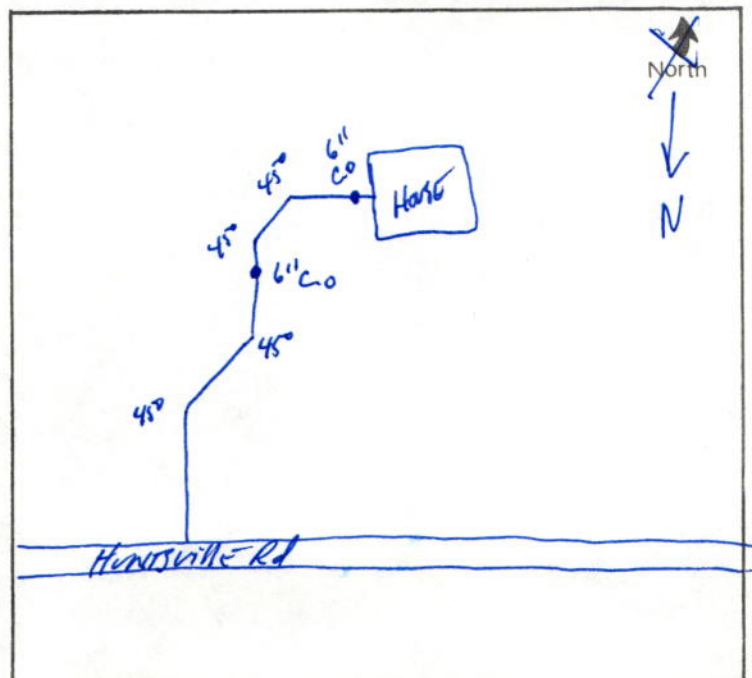



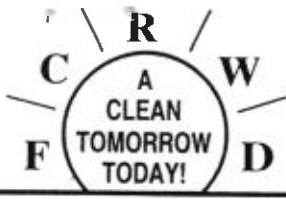

## FALL CREEK REGIONAL WASTE DISTRICT

P.O. Box 59 • 9378 S. 650 West • Pendleton, Indiana 46064-0059 • (317) 778-7544

---

February 22, 1994


Mr. Kenneth Robertson  
1977 W. Huntsville Rd  
Pendleton, IN 46064

Dear Mr. Robertson:


This is to confirm the extension of the connect requirement of your property to the sanitary main on Huntsville Road per the visit to our office of your contractor on February 18, 1994.

Due to workload of your excavating contractor, the required connection date is extended to March 18, 1994.

Sincerely,

  
J.F. Rowlett  
General Manager

CC: Mr. Randy Sorrell  
Attorney

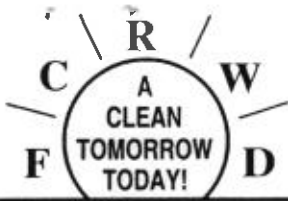

## FALL CREEK REGIONAL WASTE DISTRICT

P.O. Box 59 • 9378 S. 650 West • Pendleton, Indiana 46064-0059 • (317) 778-7544

---

February 28, 1994

Mr. & Mrs. Robertson  
1977 W. Huntsville Road  
Pendleton, IN 46064

RE: 1977 W. Huntsville Road

Dear Mr. & Mrs. Robertson:

This is a reminder that in accordance with Ordinance 92-4, an Acreage-Based Availability Fee Assessment of \$2,000.00 for your property was due Fall Creek Regional Waste District on February 24, 1994. A Time Payment Plan is available for this Assessment. If interested in the details of the Time Payment Plan, please call our Office Manager at 778-7544 for details.

Sincerely,

  
J.F. Rowlett  
General Manager

JFR/dlw

CC: Mr. Randy Sorrell  
Attorney