

#6526

This Agreement made and entered into this 18 day of August, 2015 between Fall Creek Regional Waste District ("District") and Mike + Laura McCard ("Applicant") regarding the provision of sanitary sewer service, and the assignment of capacity in and connection to, the District's facilities for the premises located at 198 Chateau Dr. Pendleton, Ind 46064.

1. The Applicant agrees that all workmanship and materials shall conform to all District ordinances and the District's construction standards. District must accept and approve all work and materials before backfilling and final connection is made to the sewer mains. Any violation of this provision will cause all lines and appurtenances in violation to be removed and replaced at the Applicant's expense.
2. The District shall have the right to enter upon the Applicant's premises at all reasonable times to inspect, repair, or replace any equipment used in connection with the District's service or which has an impact on said service.
3. The Applicant shall be responsible for all monthly user rates, capacity charges, and tap fees. The failure to pay any rate charge or fee may result in a lien against the property and/or the termination of service to the property, the cost of which will be borne by Applicant, including, but not limited to, all attorney's fees and collection costs.
4. The District shall not be responsible for any damages as a result of any failure to supply service unless said damages are due to default, neglect or culpability on the part of the District.
5. If there is an available sanitary sewer within three hundred (300) feet of the property line, the property owner shall be required to connect to the District's sanitary sewer system.
6. The Applicant and District agree that the provision of sanitary sewer service touches and concerns the property and the terms of this Agreement bind the District and Applicant and their heirs, executors, administrators, personal representatives, successors, agents, attorneys, assigns, designees, and transferees.

APPLICANT
Kyrin Madden
Signature

Signature Rachel E. Anderson
Printed Rachel E. Anderson
Notary Public
Resident of Madison County

Notes: _____

Size Pipe 6" Type Pipe PVC 35

Basement Yes No

Sump Pump Yes No

Downspout to Ground Yes No NA


Septic Tank Pumped & Filled Yes No

Contractor Chambers & Co.

Special Conditions _____

Existing Home _____

New Construction ✓

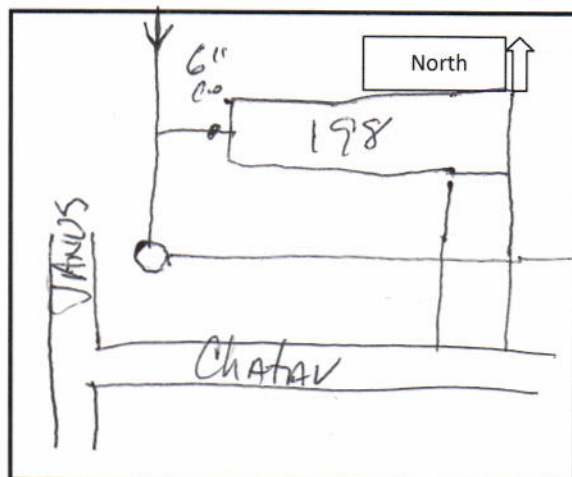

1 picture attached

198 Chateau Dr



HALLMARK HOMES, INC.

433 E. 53RD STREET
ANDERSON, IN 46013
765-644-6566

Star Financial Bank

Indianapolis, IN 46255
71-167/749
71-167/749

120828

7/30/2015

PAY TO THE
ORDER OF

FALL CREEK REGIONAL WASTE DISTRICT

\$ 3370.00

Three thousand three hundred Seventy dollars ⁰⁰/₁₀₀ DOLLARS

MEMO

MCCORD SEWER TAP

Deek Wille

AUTHORIZED SIGNATURE

Rec. # 010372

Cap fee

Tap fee for 198 Chateau Dr.

Lot. 98