

FALL CREEK REGIONAL WASTE DISTRICT

9378 S 650 WEST, P.O. BOX 59, PENDLETON, IN 46064

765-778-7544

AGREEMENT FOR SANITARY SEWER SERVICE

This Agreement made and entered into this 13th day of September, 2005, between FALL CREEK REGIONAL WASTE DISTRICT ("District") and Davis Homes ("Applicant") regarding the provision of sanitary sewer service, and the assignment of capacity in, and connection to, the District's facilities for the premises located at Huntzinger Farms lot 30

NOW THEREFORE, the parties, in consideration of the mutual promises set out in this Agreement, the receipt and sufficiency of which is hereby acknowledged, agree as follows:

1. The Applicant agrees that all workmanship and materials shall conform to all District ordinances and the District's construction standards. District must accept and approve all work and materials before backfilling and final connection is made to the sewer mains. Any violation of this provision will cause all lines and appurtenances in violation to be removed and replaced at the Applicant's expense.
2. The District shall have the right to enter upon the Applicant's premises at all reasonable times to inspect, repair, or replace any equipment used in connection with the District's service or which has an impact on said service.
3. The Applicant shall be responsible for all monthly user rates, capacity charges, and tap fees. The failure to pay any rate charge or fee may result in a lien against the property and/or the termination of service to the property, the cost of which will be borne by Applicant, including, but not limited to, all attorney's fees and collection costs.
4. The District shall not be responsible for any damages as a result of any failure to supply service unless said damages are due to default, neglect or culpability on the part of the District.
5. If there is an available sanitary sewer within three hundred (300) feet of the property line, the property owner shall be required to connect to the District's sanitary sewer system.
6. The Applicant and District agree that the provision of sanitary sewer service touches and concerns the property and the terms of this Agreement bind the District and Applicant and their heirs, executors, administrators, personal representatives, successors, agents, attorneys, assigns, designees, and transferees.

The parties hereto have read and fully understand the above provisions and agree to comply with said provisions.

FALL CREEK REGIONAL WASTE DISTRICT
Signature Deborah L. Wilson

APPLICANT
Signature Dennis Long

STATE OF INDIANA)
) SS:
COUNTY OF MADISON)

SUBSCRIBED and sworn to before me this 13th day of September, 2005.

My Commission Expires:
2-20-2008

Signature Deborah L. Wilson
Printed Deborah L. Wilson

Notary Public
Resident of Madison County

INSPECTOR Don DATE INSPECTED 11-4-05 APPROVED ✓ REJECTED _____

REASON FOR REJECTION _____

DATE REINSPECTED _____ APPROVED _____ REJECTED _____

NOTES:
SIZE PIPE 6" TYPE PIPE PVC 35

BASEMENT YES _____ NO ✓

SUMP PUMP YES _____ NO ✓

DOWNSPOUT TO GROUND YES ✓ NO _____


SEPTIC TANK PUMPED & FILLED YES NO NO _____

CONTRACTOR FAIRLAND EXC.

SPECIAL CONDITIONS _____

EXISTING HOME _____

NEW CONSTRUCTION ✓

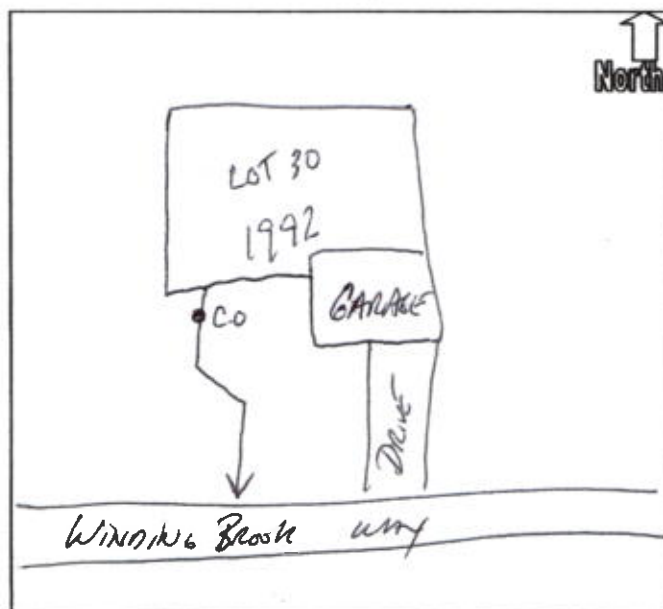

PAY TO:
Fall Creek Reg Waste Dis
9378 South 650 West
Pendleton, IN 46064

Davis Homes, LLC

Page 1 of 1

VENDOR NO.	CHECK DATE	CHECK NO	CHECK TOTAL
fal93	9/12/2005	259245	\$2,635.00

Invoice	Date	Description	Gross Amt	Adjusts	Net Amount
hfc30	09/12/05	Sewer Permit	2635.00	0.00	2635.00
hfc30	TBD	hfc01 Huntzinger Farms-Cold Springs			
Check Subtotal ----->>			2635.00	0.00	2635.00
=====					

Davis Homes, LLC
3755 East 82nd Street
Suite 120
Indianapolis, IN 46240

First Indiana Bank
Indianapolis, IN 46204

20-7043
2749

CHECK NO.
259245
9/12/2005

PAY ***Two Thousand Six Hundred And Thirty Five Dollars Only*****

***\$2,635.00*

To
The
Order
Of

Fall Creek Reg Waste Dis
9378 South 650 West
Pendleton, IN 46064



⑈00259245⑈ ⑆274070439⑆ 010080104⑈