

2 pictures attached

200 Ann Ave


Don Moore
8.16.17



200 Ann Ave

Don Moore
8-16-17

Merry Huns
8-16-17
Michael Exc.

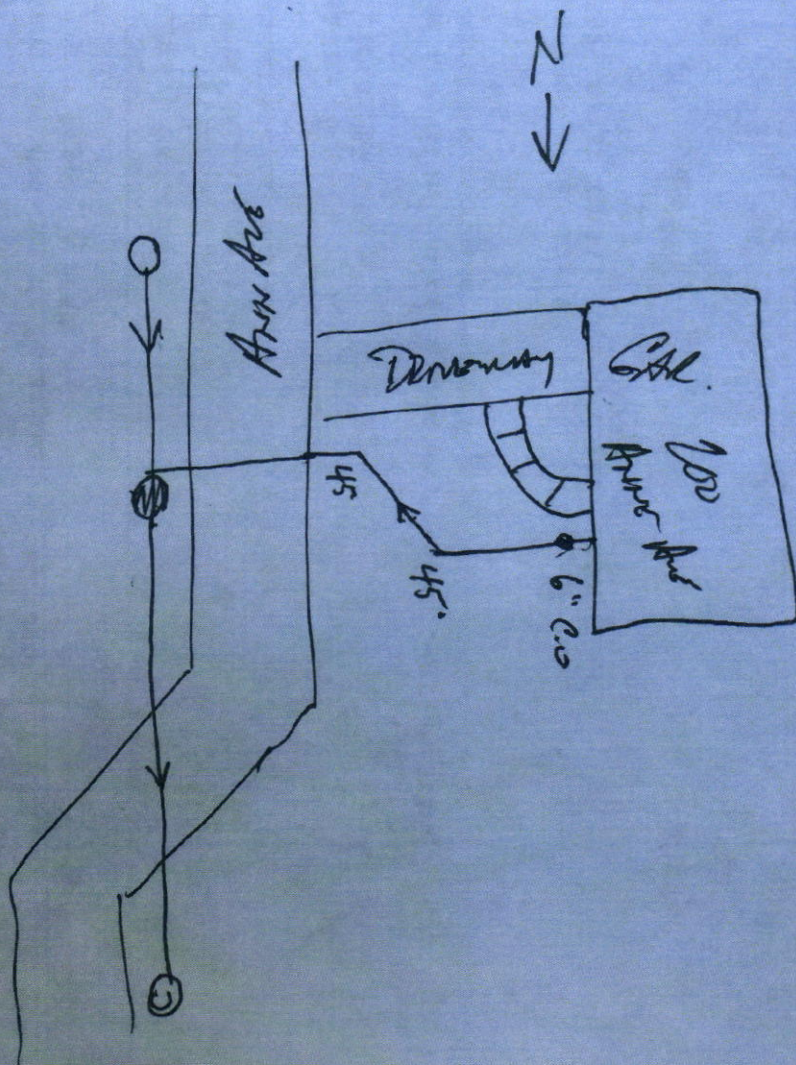

MICHAEL'S CONSTRUCTION CO.

JACK L. MICHAEL

1625 E.45 TH. STREET

ANDERSON, IN 46013

765-620-0547

71-7258/2748

© 2007 Styles Check Company
Patented & Registered

4028

Date 8-17

Pay to the
Order of

FCRWD

\$ 3370 ⁰⁰/₁₀₀

Shirley L. Michael

Dollars



Security Features
Included
Details on Back

LAMPCO FEDERAL CREDIT UNION

WWW.LAMPCO.COM

For 200 ARW AUB

[Signature]

MP

Rec # 010660