


Gidw.

PROJECT Phase II SHEET _____ OF _____
SUBJECT _____ DATE 3-14-18
JOB NO. 4447
BY Atlas

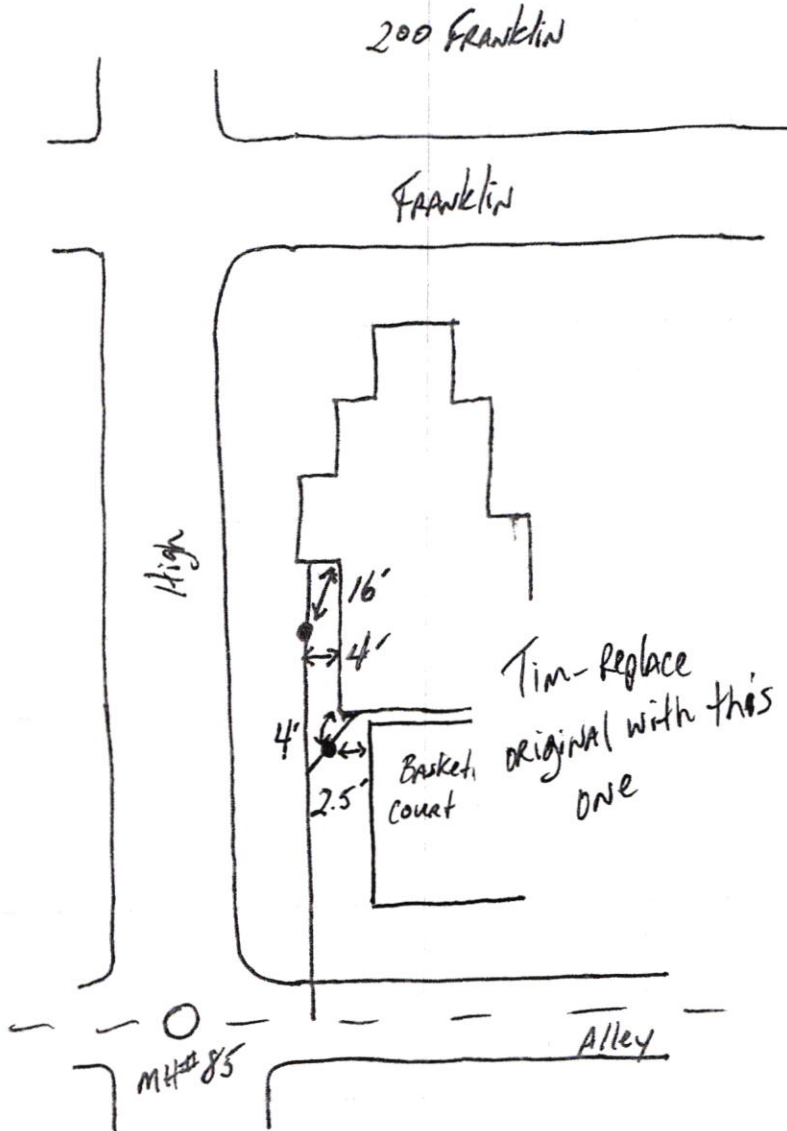

Gidw.

PROJECT Phase II


SHEET _____ OF _____

SUBJECT _____

DATE 3-14-18

JOB NO. 4447

BY Atlas

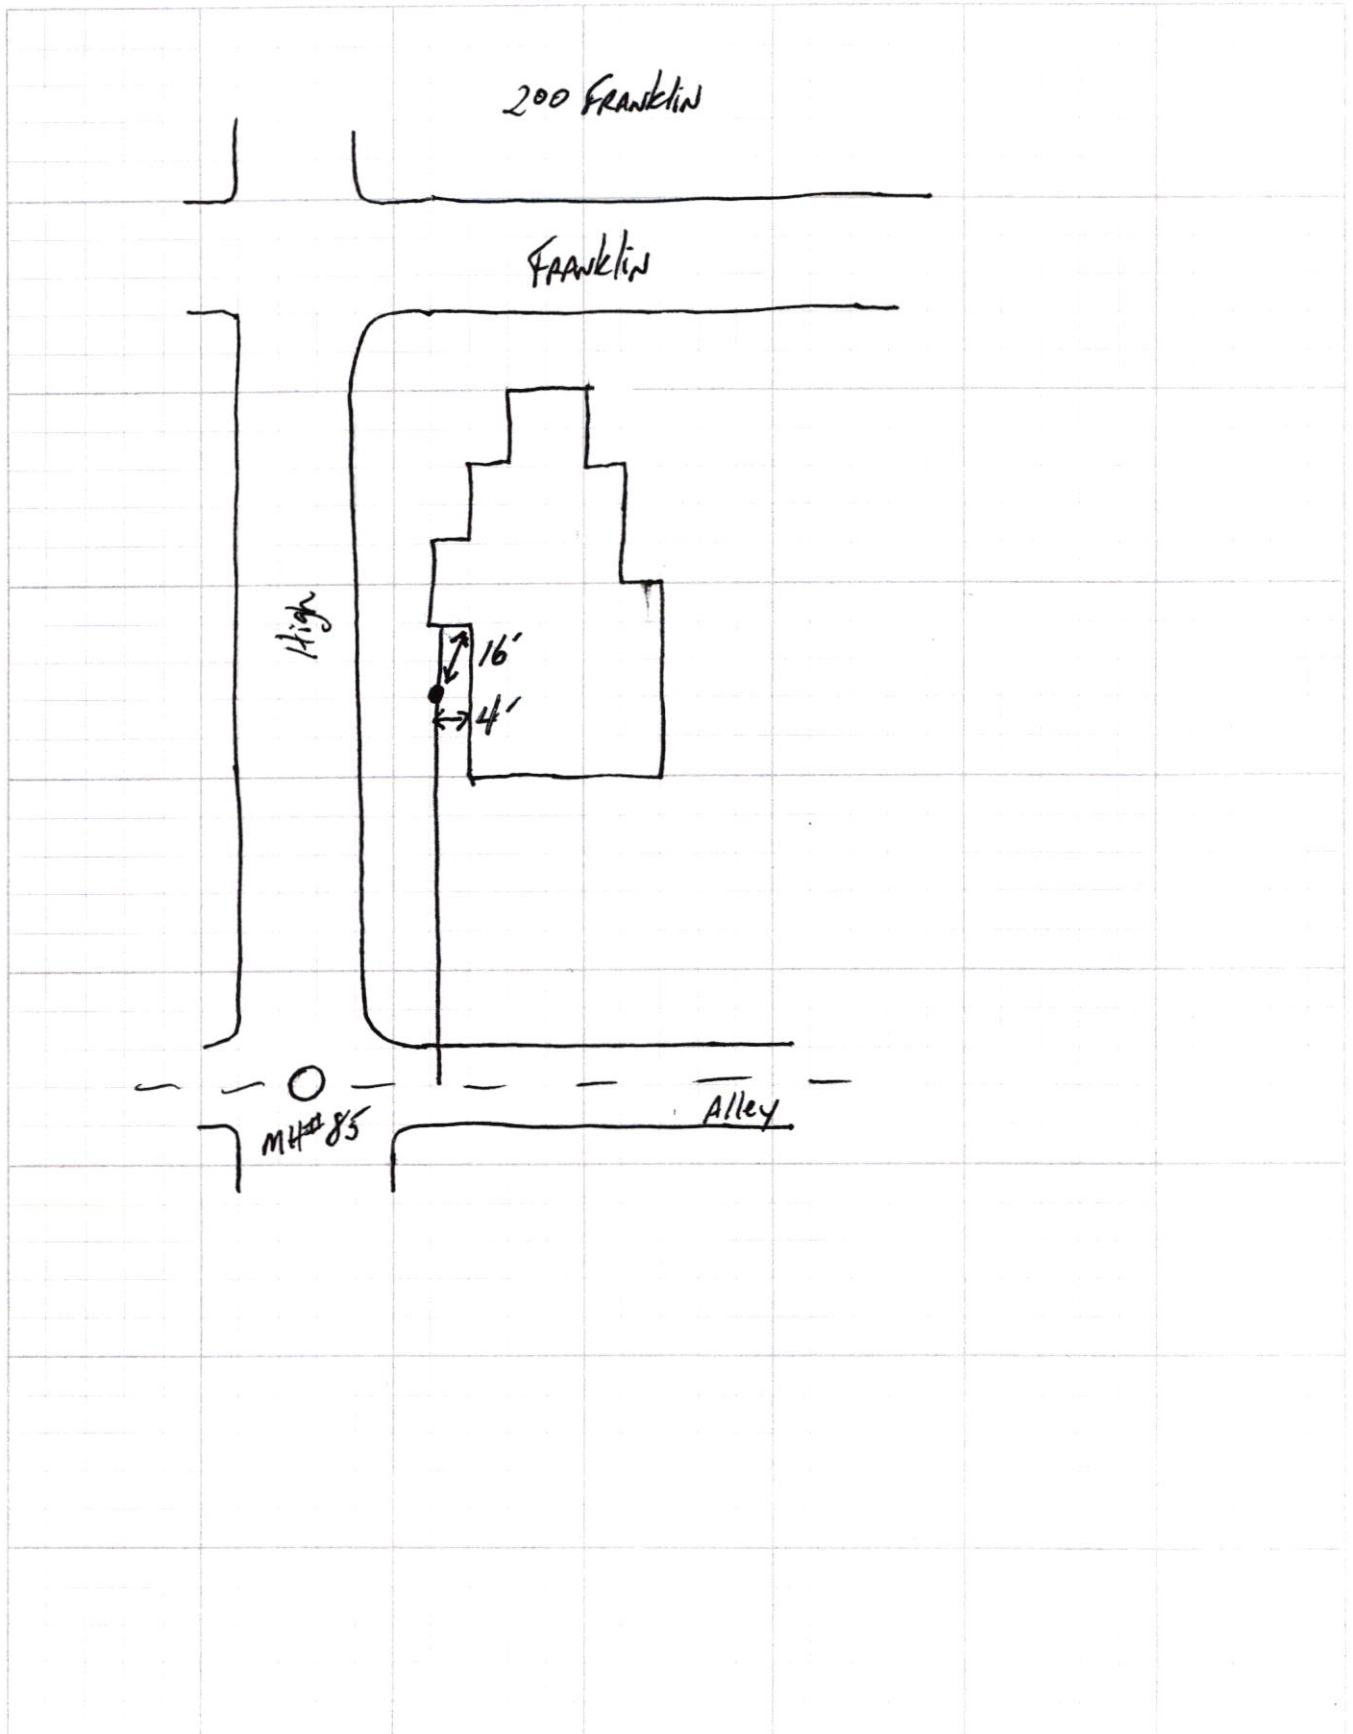

200 Franklin

SRP Phase II



200 Franklin

SRP
Phase II

4.20.18

