


Gidw.

PROJECT Phase II SHEET _____ OF _____

SUBJECT _____ DATE 8-1-18

JOB NO. 4447

BY Atlas

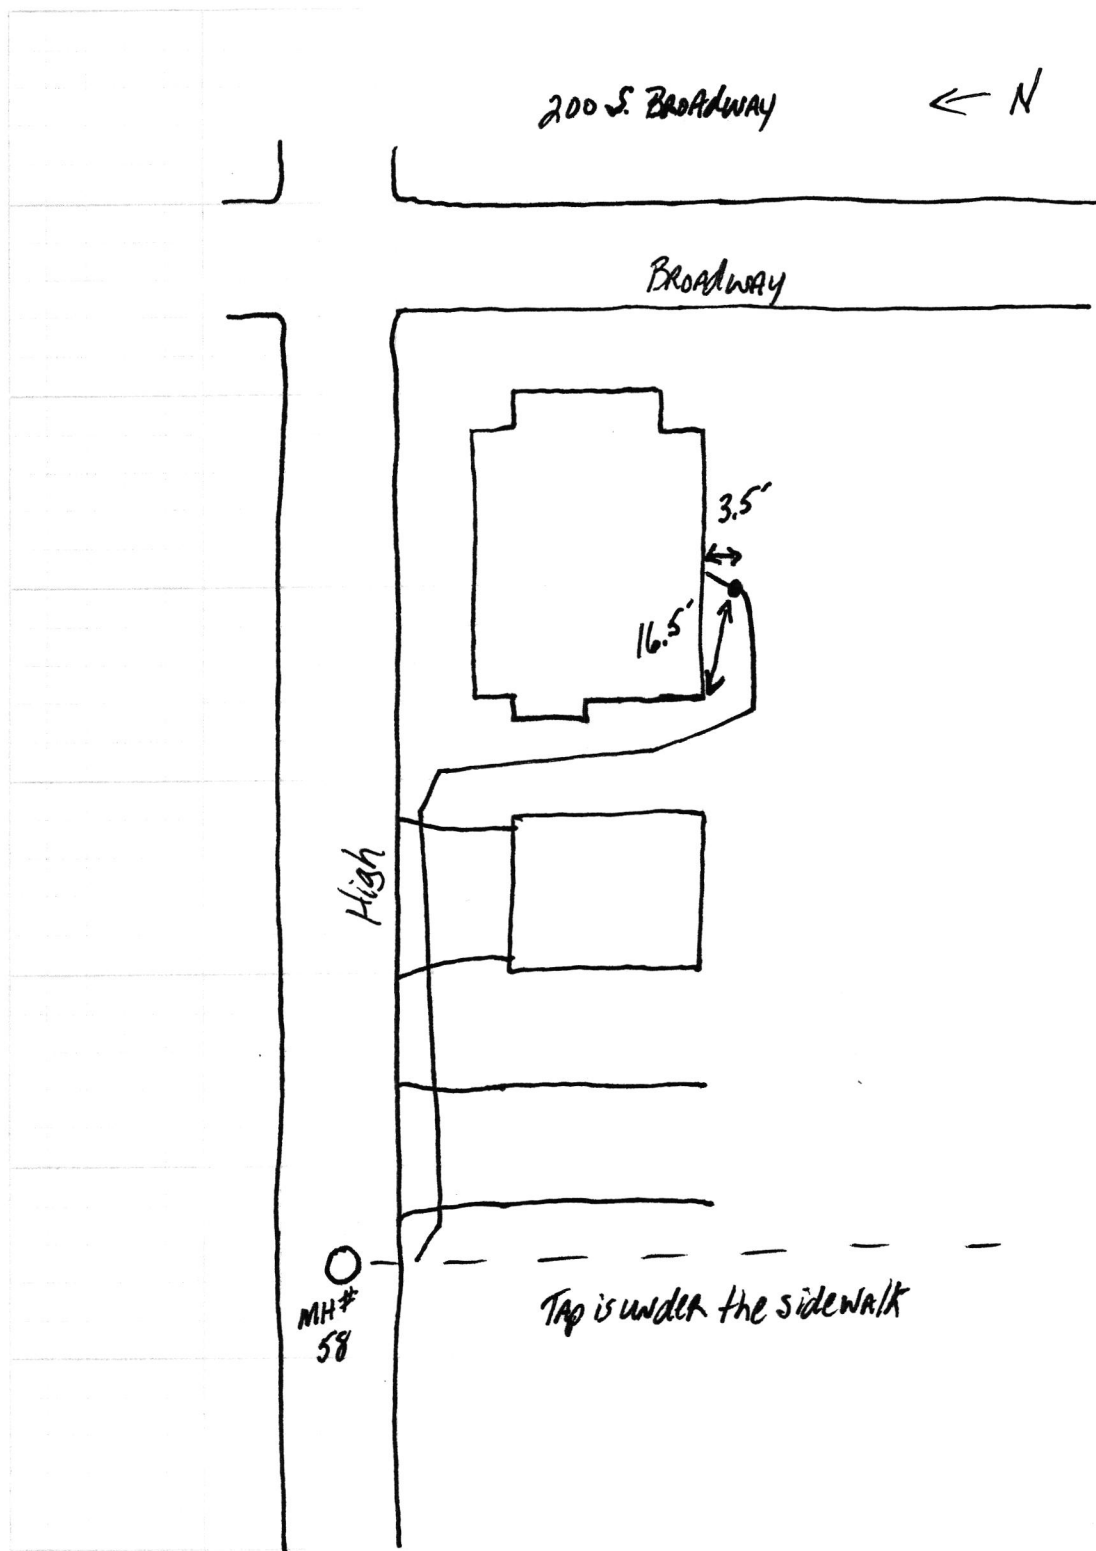

Qu & Broadview

SRE Phase II

8.15.18





FALL CREEK REGIONAL WASTE DISTRICT

9378 S. 650 West PO Box 59
Pendleton, IN 46064-0059 778-7544

APPLICATION FOR SEWER PERMIT

No 2657

Date

11/23/98

Permit Void 90 days from Date of Issuance

Owner Name

Roy Kuhns

Property Address

202 S Broadway

Lot #

P.O. Box

Town

Pendleton

IN

Zip Code

46064

Phone

City Water

Well

\$

N/A

Tap on Fee Paid

\$

N/A

Inspection fee paid

lateral replacement

Application is hereby made for connection to the Fall Creek Regional Waste District Sewer System for the above listed property - Permit Type: Residential ☒, Commercial ☐, Industrial ☐, or Governmental/Institutional ☐. User Information _____.

All workmanship and materials shall conform to the standards of the District Ordinance as described in Ordinance 84-2 and 84-3 as amended. Acceptance and approval must be made by the District inspector or his duly authorized representative before backfilling and final connection is made to the main sewer lines. Any violation of applicable regulations will cause all lines and appurtenances in violation to be removed and replaced at the owners expense.

The Fall Creek Regional Waste District is responsible for the inspection, approval of materials, and installation techniques only. All costs for materials and installation and any liabilities resulting from same is the sole responsibility of the property owner.

I have read and fully understand the above provisions and agree to comply by said provisions.

APPLICANT(S) SIGNATURE

INSPECTOR

Date inspected

11-18-98

Approved

☒

Rejected

Reason for rejection

Date reinspected

Approved

Rejected

Notes:

Size Pipe

4

Type Pipe

PVC

Basement

Yes

No ☒

Sump Pump

Yes

No ☒

Downspout to Ground

Yes ☒

No

Septic Tank Pumped & filled

Yes ☒

No

Contractor

KUHNS

Special Conditions

Existing Home

☒

New Construction

