

Gidw.

PROJECT Phase II SHEET _____ OF _____


SUBJECT _____ DATE 7-26-18

JOB NO. 4447

BY Atlas

201 E. State

↑
N

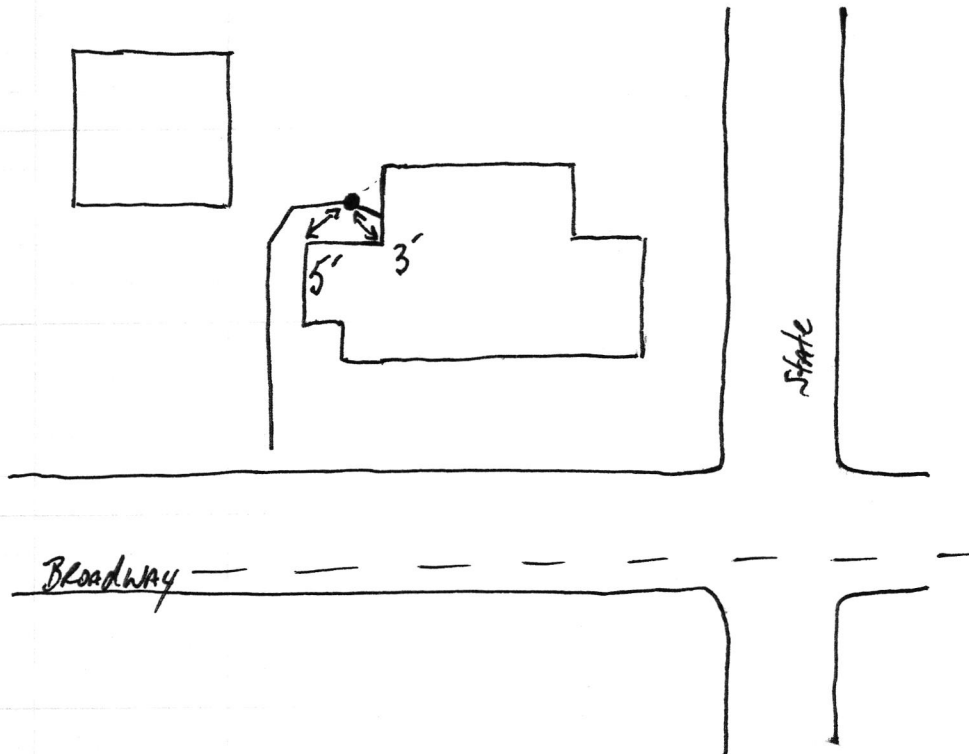

201 E State

SAP Phase II

7.30.18

