

# FALL CREEK REGIONAL WASTE DISTRICT

9378 S 650 WEST, P.O. BOX 59, PENDLETON, IN 46064

765-778-7544

## AGREEMENT FOR SANITARY SEWER SERVICE

4237

This Agreement made and entered into this 9<sup>th</sup> day of April, 2001, between FALL CREEK REGIONAL WASTE DISTRICT ("District") and Ed Springer ("Applicant") regarding the provision of sanitary sewer service, and the assignment of capacity in, and connection to, the District's facilities for the premises located at 201 Marcy Avenue.

NOW THEREFORE, the parties, in consideration of the mutual promises set out in this Agreement, the receipt and sufficiency of which is hereby acknowledged, agree as follows:

1. The Applicant agrees that all workmanship and materials shall conform to all District ordinances and the District's construction standards. District must accept and approve all work and materials before backfilling and final connection is made to the sewer mains. Any violation of this provision will cause all lines and appurtenances in violation to be removed and replaced at the Applicant's expense.

2. The District shall have the right to enter upon the Applicant's premises at all reasonable times to inspect, repair, or replace any equipment used in connection with the District's service or which has an impact on said service.

3. The Applicant shall be responsible for all monthly user rates, capacity charges, and tap fees. The failure to pay any rate charge or fee may result in a lien against the property and/or the termination of service to the property, the cost of which will be borne by Applicant, including, but not limited to, all attorney's fees and collection costs.

4. The District shall not be responsible for any damages as a result of any failure to supply service unless said damages are due to default, neglect or culpability on the part of the District.

5. If there is an available sanitary sewer within three hundred (300) feet of the property line, the property owner shall be required to connect to the District's sanitary sewer system.

6. The Applicant and District agree that the provision of sanitary sewer service touches and concerns the property and the terms of this Agreement bind the District and Applicant and their heirs, executors, administrators, personal representatives, successors, agents, attorneys, assigns, designees, and transferees.

The parties hereto have read and fully understand the above provisions and agree to comply with said provisions.

FALL CREEK REGIONAL WASTE DISTRICT

Signature

APPLICANT

Signature

STATE OF INDIANA )

) SS:

COUNTY OF MADISON )

SUBSCRIBED and sworn to before me this 9<sup>th</sup> day of April, 2001.

My Commission Expires:

4-19-2008

Signature

Printed

Notary Public

Resident of Madison County

\*\*\*\*\*  
INSPECTOR \_\_\_\_\_ DATE INSPECTED \_\_\_\_\_ APPROVED \_\_\_\_\_ REJECTED \_\_\_\_\_

REASON FOR REJECTION \_\_\_\_\_

DATE REINSPECTED \_\_\_\_\_ APPROVED \_\_\_\_\_ REJECTED \_\_\_\_\_

NOTES:

SIZE PIPE \_\_\_\_\_ TYPE PIPE \_\_\_\_\_

BASEMENT YES \_\_\_\_\_ NO \_\_\_\_\_

SUMP PUMP YES \_\_\_\_\_ NO \_\_\_\_\_

DOWNSPOUT TO GROUND YES \_\_\_\_\_ NO \_\_\_\_\_

SEPTIC TANK PUMPED & FILLED YES \_\_\_\_\_ NO \_\_\_\_\_

CONTRACTOR \_\_\_\_\_

SPECIAL CONDITIONS \_\_\_\_\_

EXISTING HOME \_\_\_\_\_

NEW CONSTRUCTION \_\_\_\_\_

North

26-00820.00

add order on file

4252

13-29360.00

FALL CREEK REGIONAL WASTE DISTRICT

9378 S 650 WEST, P.O. BOX 59, PENDLETON, IN 46064

765-778-7544

AGREEMENT FOR SANITARY SEWER SERVICE

This Agreement made and entered into this 12<sup>th</sup> day of April, 2001, between FALL CREEK REGIONAL WASTE DISTRICT ("District") and Edward Spangler ("Applicant") regarding the provision of sanitary sewer service, and the assignment of capacity in, and connection to, the District's facilities for the premises located at 201 Marcy Avenue.

NOW THEREFORE, the parties, in consideration of the mutual promises set out in this Agreement, the receipt and sufficiency of which is hereby acknowledged, agree as follows:

- 1. The Applicant agrees that all workmanship and materials shall conform to all District ordinances and the District's construction standards. District must accept and approve all work and materials before backfilling and final connection is made to the sewer mains. Any violation of this provision will cause all lines and appurtenances in violation to be removed and replaced at the Applicant's expense.
- 2. The District shall have the right to enter upon the Applicant's premises at all reasonable times to inspect, repair, or replace any equipment used in connection with the District's service or which has an impact on said service.
- 3. The Applicant shall be responsible for all monthly user rates, capacity charges, and tap fees. The failure to pay any rate charge or fee may result in a lien against the property and/or the termination of service to the property, the cost of which will be borne by Applicant, including, but not limited to, all attorney's fees and collection costs.
- 4. The District shall not be responsible for any damages as a result of any failure to supply service unless said damages are due to default, neglect or culpability on the part of the District.
- 5. If there is an available sanitary sewer within three hundred (300) feet of the property line, the property owner shall be required to connect to the District's sanitary sewer system.
- 6. The Applicant and District agree that the provision of sanitary sewer service touches and concerns the property and the terms of this Agreement bind the District and Applicant and their heirs, executors, administrators, personal representatives, successors, agents, attorneys, assigns, designees, and transferees.

The parties hereto have read and fully understand the above provisions and agree to comply with said provisions.

FALL CREEK REGIONAL WASTE DISTRICT  
Debra Wilson  
Signature

APPLICANT  
\_\_\_\_\_  
Signature

STATE OF INDIANA )  
                                  ) SS:  
COUNTY OF MADISON )

SUBSCRIBED and sworn to before me this \_\_\_\_\_ day of \_\_\_\_\_, 200\_\_.

My Commission Expires: \_\_\_\_\_

Signature \_\_\_\_\_  
Printed \_\_\_\_\_  
Notary Public  
Resident of Madison County


\*\*\*\*\*

INSPECTOR JB DATE INSPECTED 4-12-01 APPROVED ✓ REJECTED \_\_\_\_\_

REASON FOR REJECTION \_\_\_\_\_

DATE REINSPECTED \_\_\_\_\_ APPROVED \_\_\_\_\_ REJECTED \_\_\_\_\_

NOTES:  
SIZE PIPE 6 TYPE PIPE 35 Citywide  
BASEMENT YES \_\_\_\_\_ NO Y  
SUMP PUMP YES \_\_\_\_\_ NO X  
DOWNSPOUT TO GROUND YES X NO \_\_\_\_\_  
SEPTIC TANK PUMPED & FILLED YES X NO \_\_\_\_\_  
CONTRACTOR Self  
SPECIAL CONDITIONS \_\_\_\_\_  
EXISTING HOME X  
NEW CONSTRUCTION \_\_\_\_\_

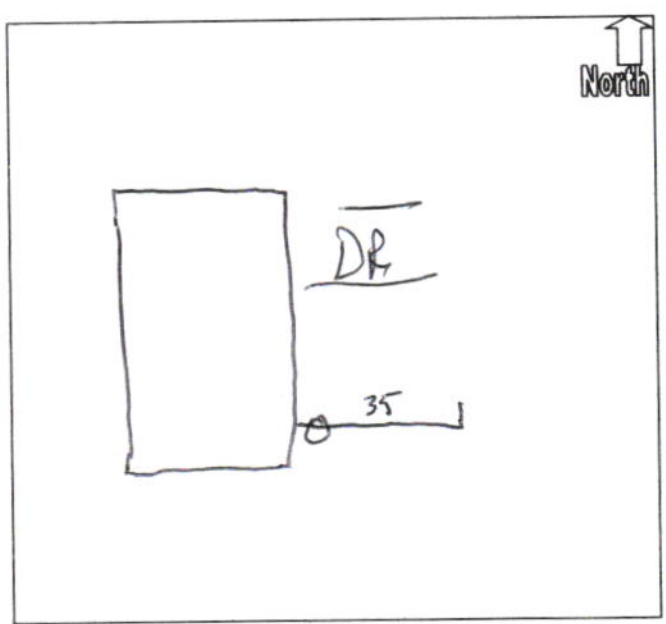

## SUPPLEMENTAL UTILITY CONFLICT INFORMATION

PROPERTY/STREET/ALLEY CROSSED

201 MARCY AVE

N-2214

LOT

CITY PENDLETONCOUNTY MADISON

UTILITY LOCATE PERFORMED BY


BUSTAMANTE-BAYLESDATE 7-11-23

DOCUMENT SIZE/DEPTH OF SEWERS WHEN CROSSING WITH PROPOSED GAS PIPELINE.

	#1	#2	#3	#4	#5	#6
SEWER DIAMETER	"	"	"	"	"	"
SEWER DEPTH	"	"	"	"	"	"
GAS DEPTH	"	"	"	"	"	"

ACTUAL PROTECTIVE METHOD(S) AGAINST SEWER TRANSECTIONS (LIST ALL THAT APPLY):

GAS MAIN \_\_\_\_\_ GAS SVC \_\_\_\_\_

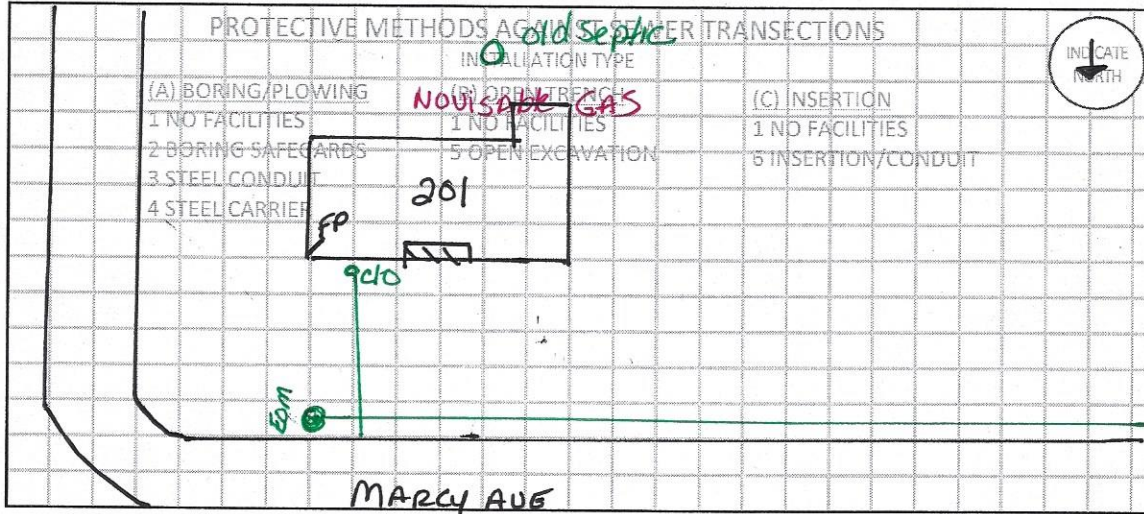

LOCATION OF SEWER FROM FIXED POINT

POINT	# FEET N DIR ORIGIN	# FEET W DIR ORIGIN	DEPTH (IN)
a	37 FT.	7 FT.	60"
b	27 FT.	6 FT.	23"
c	14 FT.	5 FT.	22"
d	FT.	FT.	"
e	FT.	FT.	"
f	FT.	FT.	"
g	FT.	FT.	"
h	FT.	FT.	"
i	FT.	FT.	"
j	FT.	FT.	"

BORE REVIEW INSPECTOR

COMPANY

FOREMAN/CREW LEAD

COMPANY

BORE OPERATOR

COMPANY

DATE OF BORE REVIEW

## SERVICE RECORD SKETCH

MAIN LOCATION \_\_\_\_\_ FT.

SERVICE TAP DIMENSIONS: \_\_\_\_\_ X \_\_\_\_\_ Y \_\_\_\_\_ Z

CURRENT TOTAL LENGTH OF ACTIVE SERVICE \_\_\_\_\_

SUPPLEMENTAL DIMENSIONS: \_\_\_\_\_ A \_\_\_\_\_ B \_\_\_\_\_ C \_\_\_\_\_ D \_\_\_\_\_ E \_\_\_\_\_ F

LENGTH OF TEST PIPE \_\_\_\_\_

SERVICE TEST PRESSURE \_\_\_\_\_ PSIG

TEST DURATION \_\_\_\_\_

TEST PERFORMED BY \_\_\_\_\_

COMPANY NAME \_\_\_\_\_

DATE \_\_\_\_\_

INDICATE NORTH

NOTES:

CONSTRUCTED BY \_\_\_\_\_

COMPANY NAME \_\_\_\_\_

EMP. NO. \_\_\_\_\_

DATE \_\_\_\_\_

INSPECTED BY \_\_\_\_\_

COMPANY NAME \_\_\_\_\_

EMP. NO. \_\_\_\_\_

DATE \_\_\_\_\_

SUPERVISOR CARD REVIEW \_\_\_\_\_

DATE \_\_\_\_\_