


Gidw.

PROJECT Phase II SHEET _____ OF _____
SUBJECT _____ DATE 6-25-18
JOB NO. 4447
BY AHAS

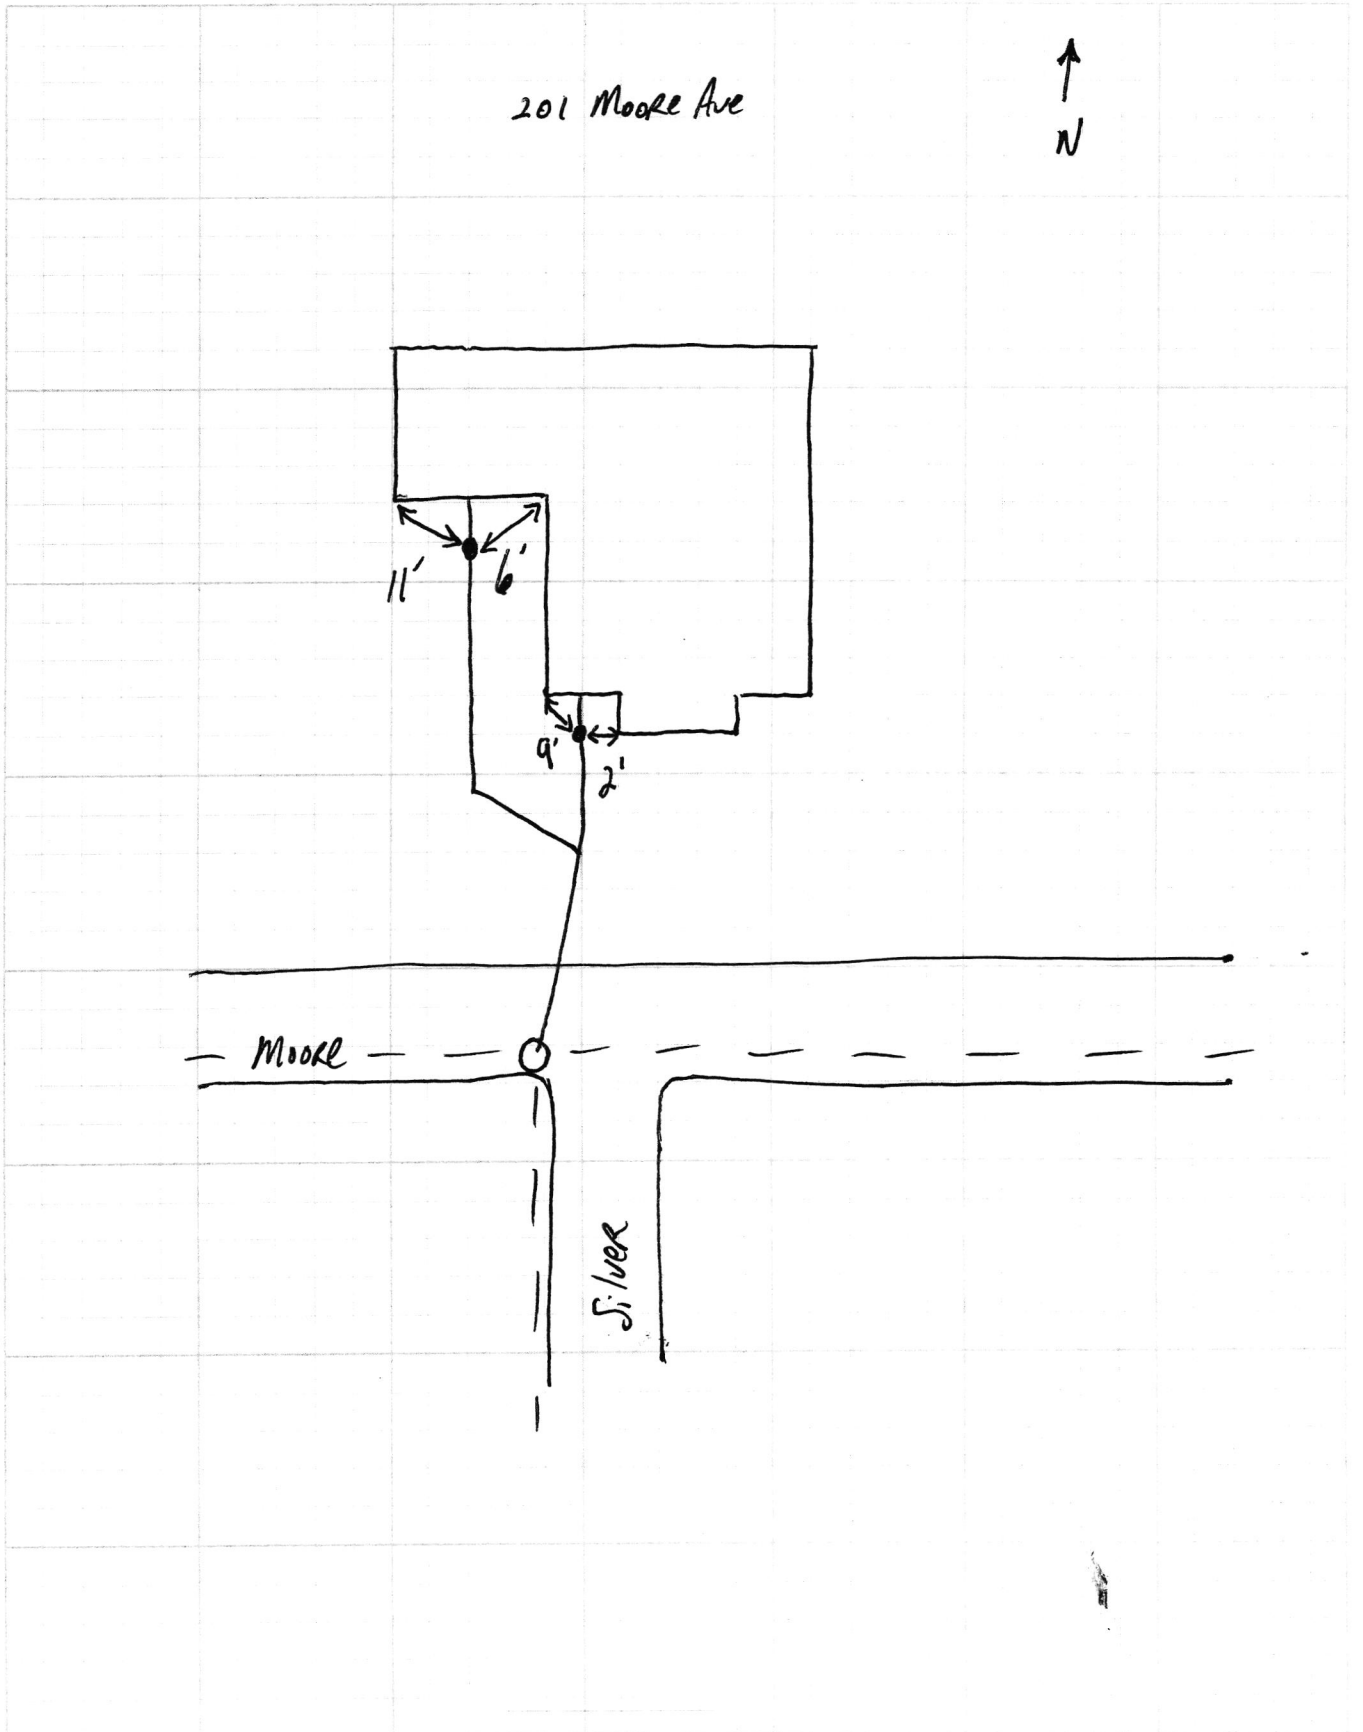

201 Moore SRF Phase II

7.6.18



001 110002

SRF Phase II

7.6.18

