


Gidw.

PROJECT Phase II SHEET _____ OF _____
SUBJECT _____ DATE 4-13-18
JOB NO. 4447
BY Atlas

202 S. MAIN

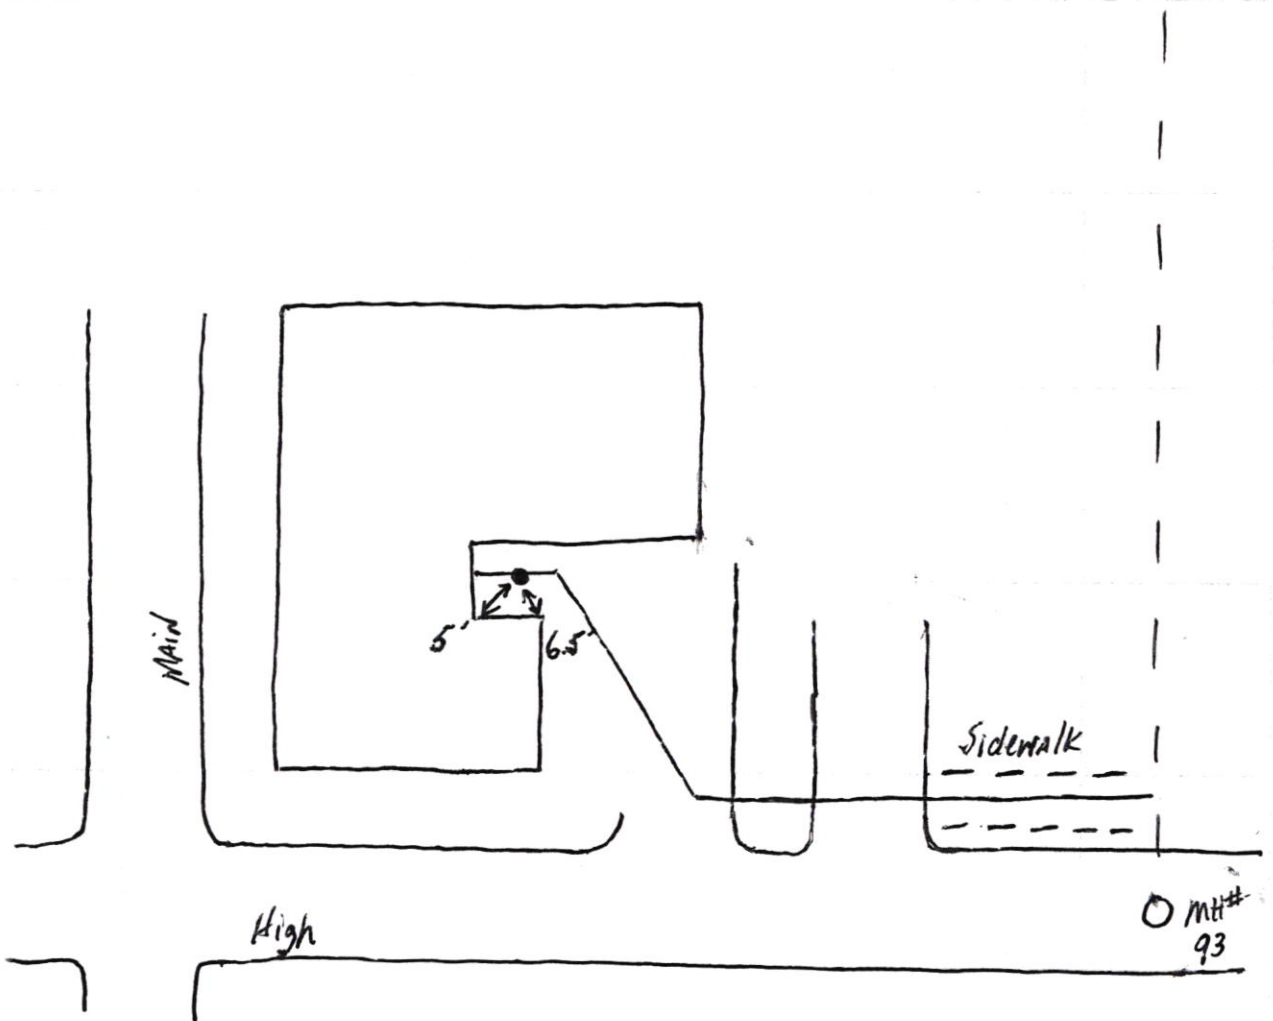

202 S Main

SRP
Phase II

4.20.18



