
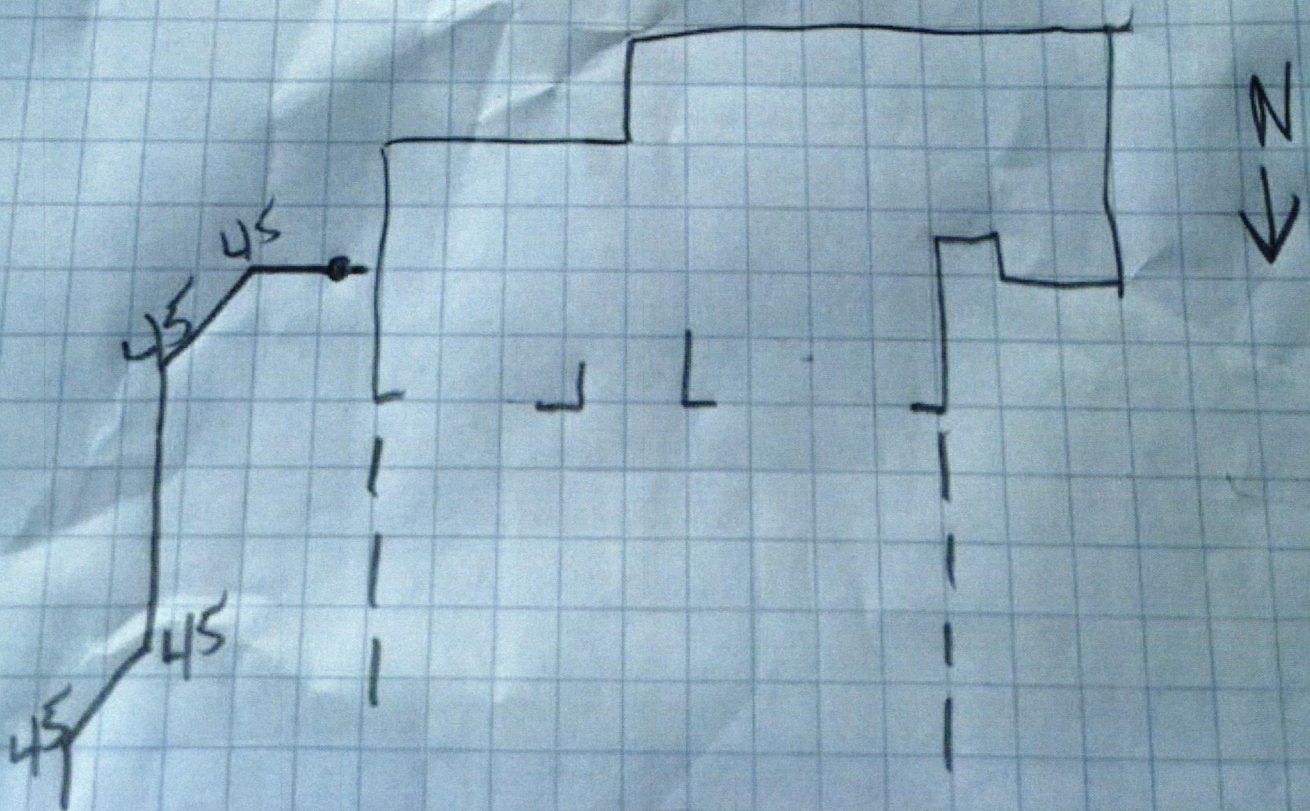


North 

Drawing  
+  
2 pictures  
attached



Maplewood Huntzingers  
Lot 170 202 winding brook  
4/17/24





lot #170

Maplewood



