


Gidw.

PROJECT Phase II SHEET _____ OF _____
SUBJECT _____ DATE 2-28-18
JOB NO 4447
BY AT/AS

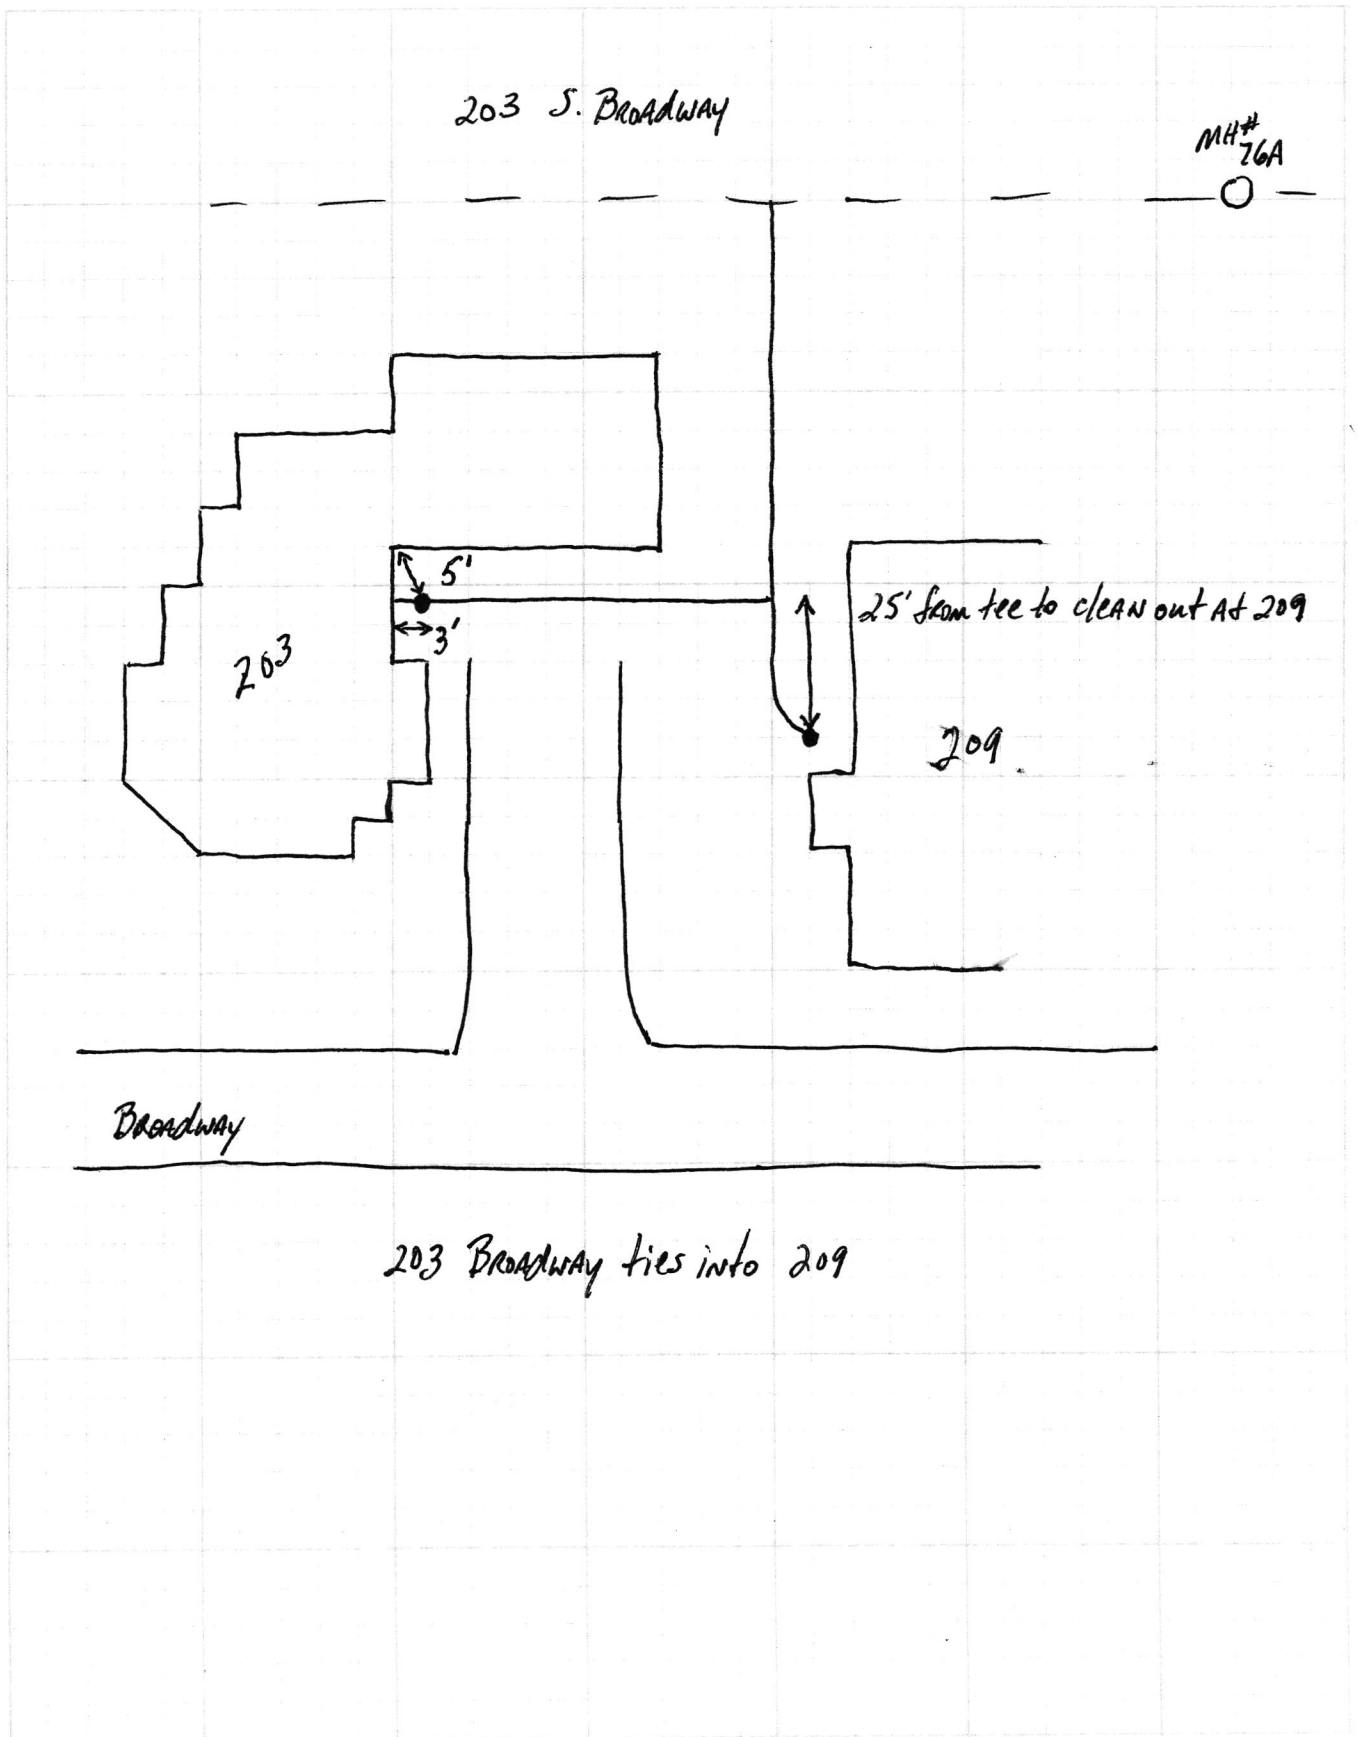

203 S Broadway

SRP Phase II

