

**Gidw.**


PROJECT Phase II SHEET \_\_\_\_\_ OF \_\_\_\_\_

SUBJECT \_\_\_\_\_ DATE 7-18-18

JOB NO. 4447

BY Atlas


204 E. State

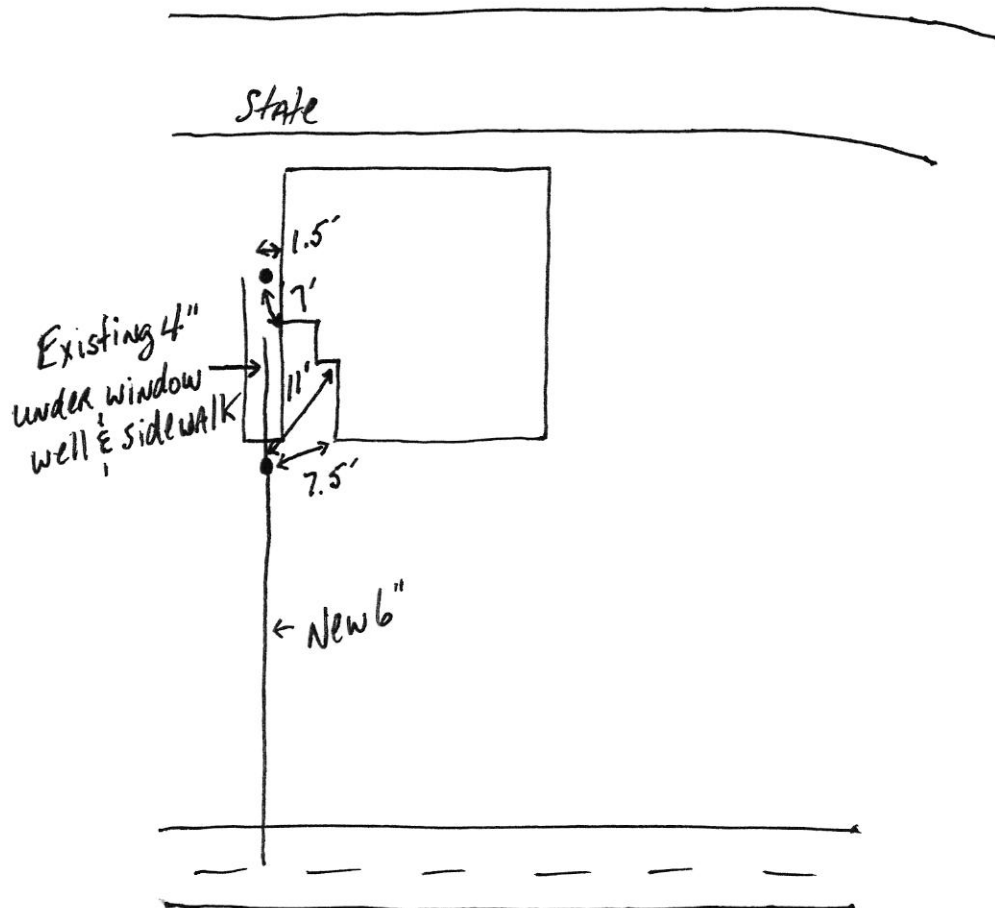

204 E State

SRT Phase II

7.30.18

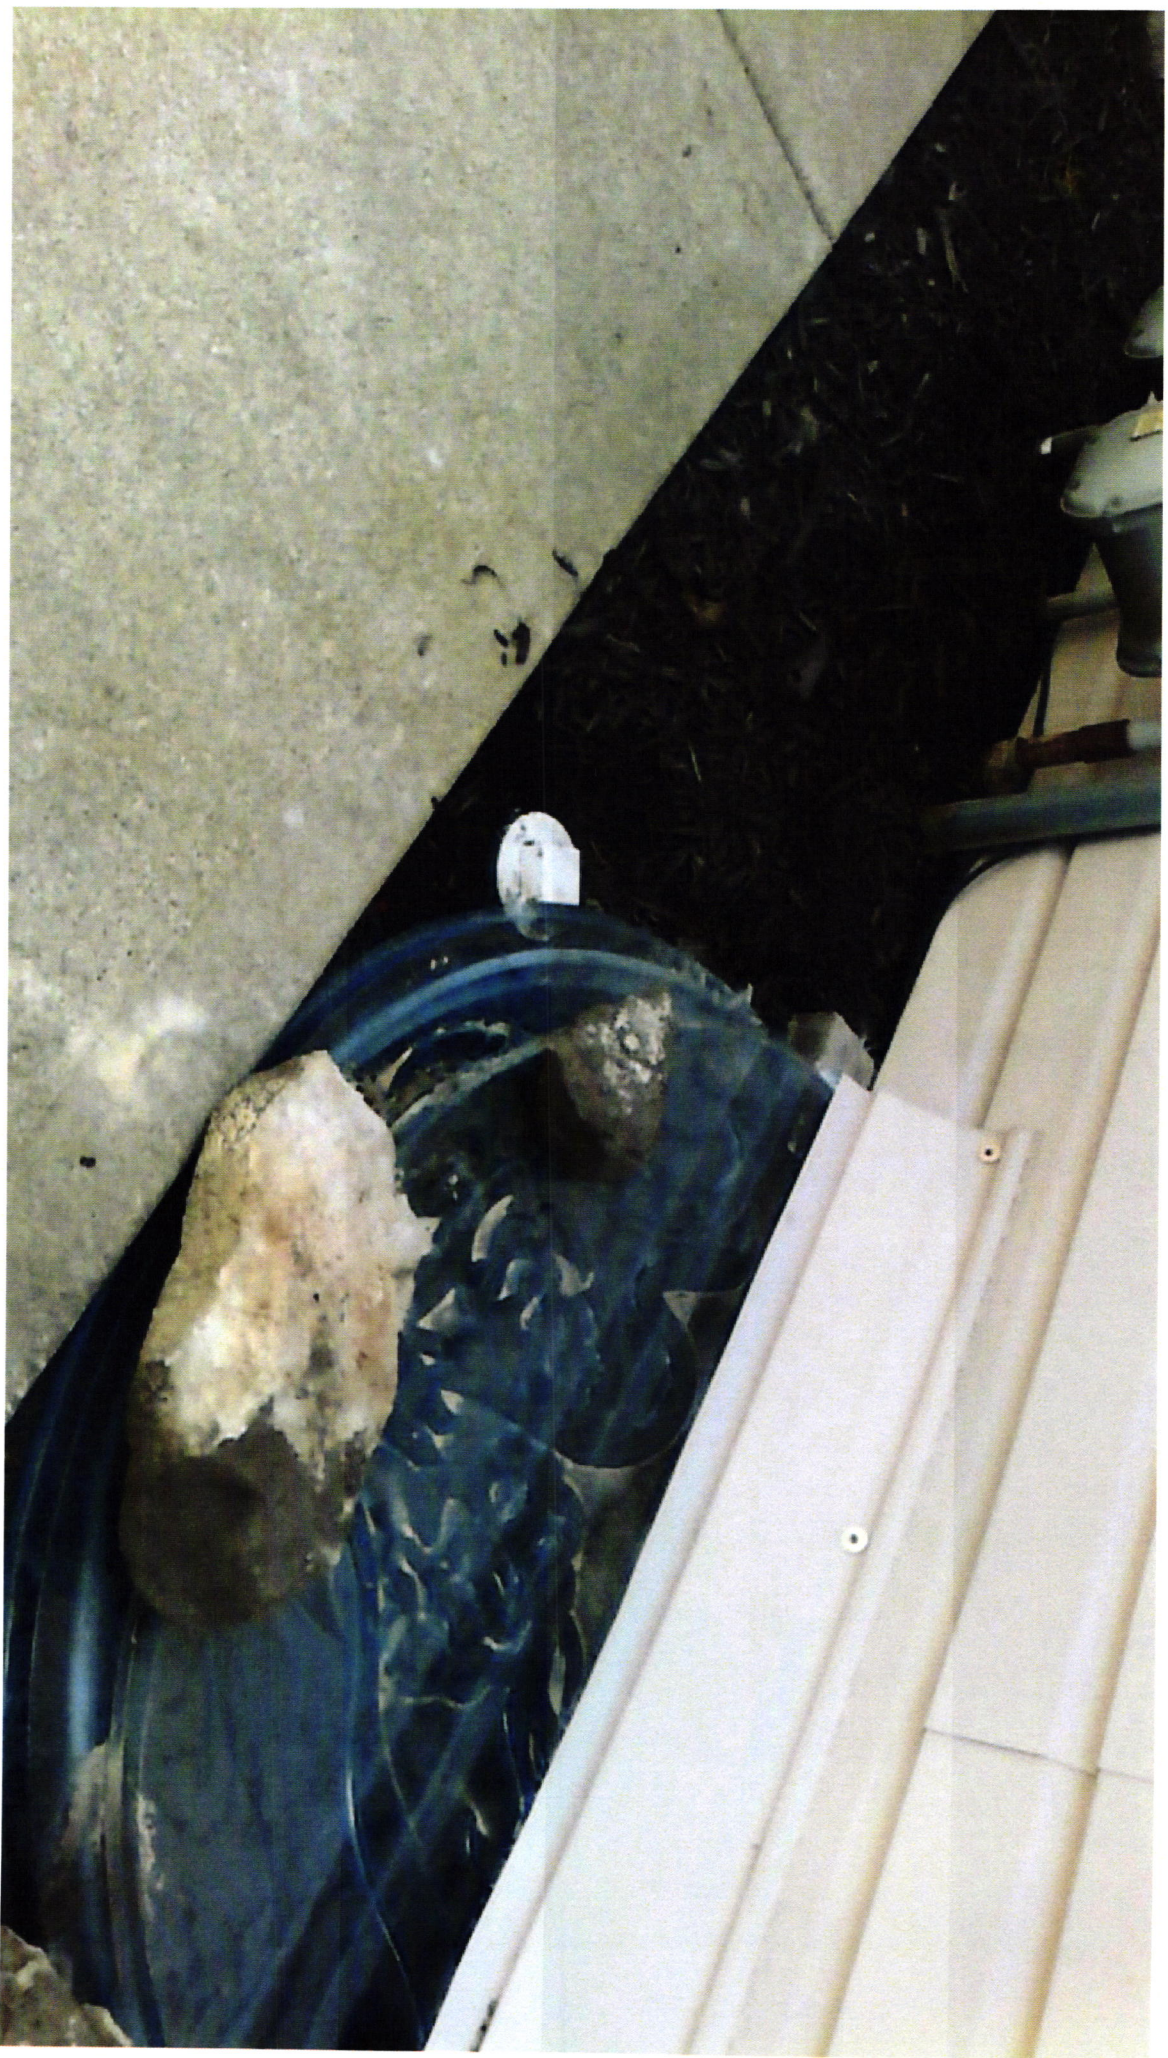

204 E Stock

SRC Phase II

7.30.18

