



FALL CREEK REGIONAL WASTE DISTRICT

Box 44, Pendleton, Indiana 46064

22-26010.00

Barnhart (contractor)

2-0026010.00

Spec Home

Nº 001708

APPLICATION FOR SEWER PERMIT

Permit No. _____ Date 12-12-89
Permit Void 90 days from Date of Issuance
Owner Name ~~XXXXXX~~
Property Address 204 Lucky Lane
Lot # 38 P.O. Box _____
Town Pendleton, IN Zip Code 46064
Phone _____ Water Meter _____"

\$ 500.00 Tap on Fee Paid

\$ 25.00 Inspection fee paid

Application is hereby made for connection to the Fall Creek Regional Waste District Sewer System for the above listed property - Permit Type: Residential ☒, Commercial _____, Industrial _____, or Governmental/Institutional _____. User Information _____.

All workmanship and materials shall conform to the standards of the District Ordinance as described in Ordinance 84-2 and 84-3 as amended. Acceptance and approval must be made by the District inspector or his duly authorized representative before backfilling and final connection is made to the main sewer lines. Any violation of applicable regulations will cause all lines and appurtenances in violation to be removed and replaced at the owners expense.

The Fall Creek Regional Waste District is responsible for the inspection, approval of materials, and installation techniques only. All costs for materials and installation and any liabilities resulting from same is the sole responsibility of the property owner.

I have read and fully understand the above provisions and agree to comply by said provisions.

X John A Barnhart
APPLICANT(S) SIGNATURE

INSPECTOR B

Date inspected 12-15-89 Approved ☒ Rejected _____

Reason for rejection _____

Date reinspected _____ Approved _____ Rejected _____

Notes:

Size Pipe 6 "

Type Pipe PVC

Basement Yes _____ No ☒


Sump Pump Yes _____ No ☒

Downspout to Ground Yes ☒ No _____

Septic Tank Pumped & filled Yes _____ No ☒

Contractor EARL DAVIS

Special Conditions NEW CONST.

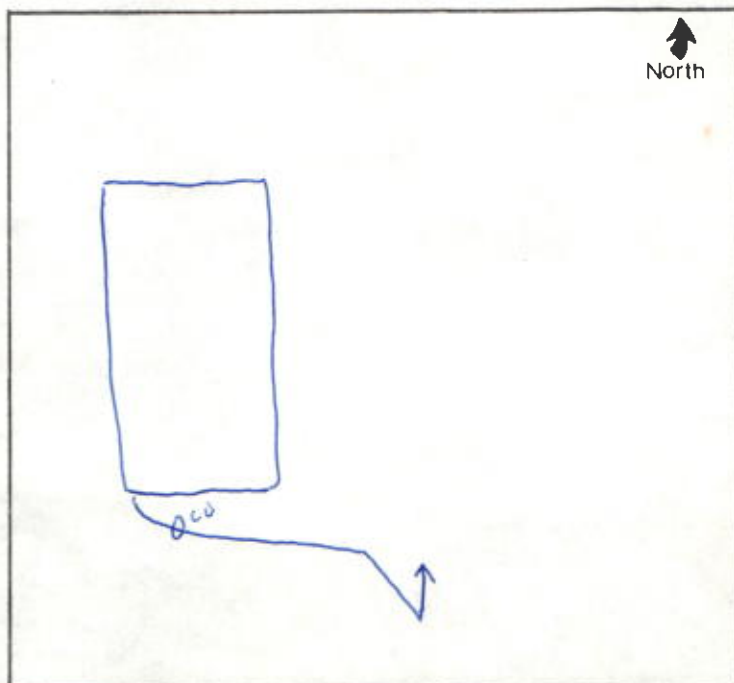



8-0034610.00


NO 001708

Invoice (continued)

Invoice # 8-0034610.00
Date 8-15-82
To: [illegible]
From: [illegible]
Description: [illegible]
Quantity: [illegible]
Unit Price: [illegible]
Total: [illegible]

The undersigned hereby certifies that the above is a true and correct copy of the invoice as it appears on the books of the undersigned. This certificate is given for the purpose of enabling the recipient to obtain credit for the amount of the invoice from the undersigned.

[Signature]
[illegible]

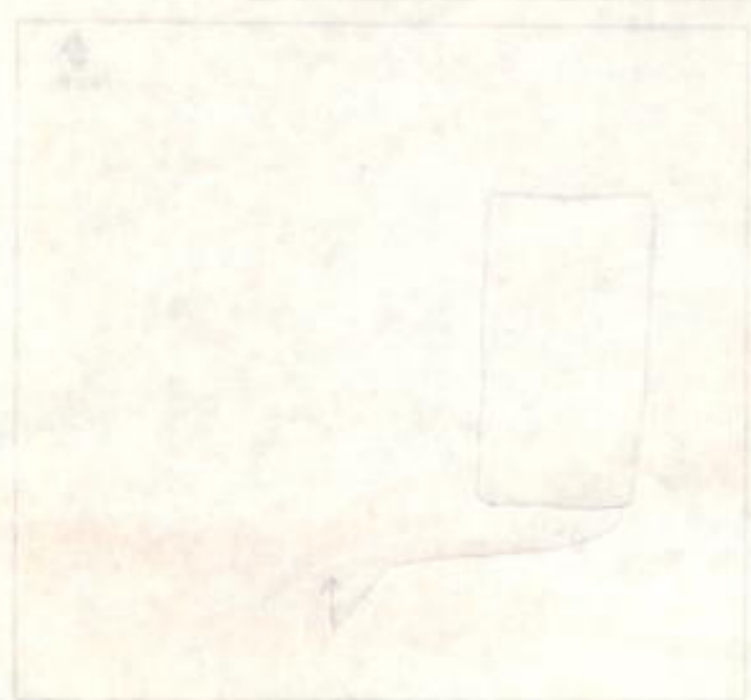

Accepted for payment by the undersigned on the date of this invoice. The undersigned hereby certifies that the above is a true and correct copy of the invoice as it appears on the books of the undersigned.



FALL CREEK REGIONAL WASTE DISTRICT

Box 44, Pendleton, Indiana 46064

Nº 001700

APPLICATION FOR SEWER PERMIT

Permit No. _____ Date 10-24-89

Permit Void 90 days from Date of Issuance

Owner Name _____

Property Address Lucky Lane

Lot # 38 P.O. Box _____

Town _____, IN Zip Code _____

Phone _____ Water Meter _____"

\$ 500.00 Tap on Fee Paid

\$ 25.00 Inspection fee paid

325.00 refunded to Dev.

Application is hereby made for connection to the Fall Creek Regional Waste District Sewer System for the above listed property - Permit Type: Residential _____, Commercial _____, Industrial _____, or Governmental/Institutional _____. User Information _____.

All workmanship and materials shall conform to the standards of the District Ordinance as described in Ordinance 84-2 and 84-3 as amended. Acceptance and approval must be made by the District inspector or his duly authorized representative before backfilling and final connection is made to the main sewer lines. Any violation of applicable regulations will cause all lines and appurtenances in violation to be removed and replaced at the owners expense.

The Fall Creek Regional Waste District is responsible for the inspection, approval of materials, and installation techniques only. All costs for materials and installation and any liabilities resulting from same is the sole responsibility of the property owner.

I have read and fully understand the above provisions and agree to comply by said provisions.

APPLICANT(S) SIGNATURE _____

INSPECTOR _____

Date inspected _____ Approved _____ Rejected _____

Reason for rejection _____

Date reinspected _____ Approved _____ Rejected _____

Notes:

Size Pipe _____"

Type Pipe _____

Basement Yes _____ No _____

Sump Pump Yes _____ No _____

Downspout to Ground Yes _____ No _____

Septic Tank Pumped & filled Yes _____ No _____

Contractor Gerry Cox

Special Conditions _____



