



FALL CREEK REGIONAL WASTE DISTRICT

Box 44, Pendleton, Indiana 46064

1-0000800.00

Nº 001747

APPLICATION FOR SEWER PERMIT

Permit No. \_\_\_\_\_ Date 6-7-90  
Permit Void 90 days from Date of Issuance  
Owner Name HAROLD McDAVIEL  
Property Address 204 N MANIFOLD  
Lot # \_\_\_\_\_ P.O. Box \_\_\_\_\_  
Town INGALLS, IN Zip Code 46048  
Phone \_\_\_\_\_ Water Meter YES  
\$ 500 Tap on Fee Paid  
\$ 25 Inspection fee paid

Application is hereby made for connection to the Fall Creek Regional Waste District Sewer System for the above listed property - Permit Type: Residential X, Commercial \_\_\_\_\_, Industrial \_\_\_\_\_, or Governmental/Institutional \_\_\_\_\_. User Information \_\_\_\_\_

All workmanship and materials shall conform to the standards of the District Ordinance as described in Ordinance 84-2 and 84-3 as amended. Acceptance and approval must be made by the District inspector or his duly authorized representative before backfilling and final connection is made to the main sewer lines. Any violation of applicable regulations will cause all lines and appurtenances in violation to be removed and replaced at the owners expense.

The Fall Creek Regional Waste District is responsible for the inspection, approval of materials, and installation techniques only. All costs for materials and installation and any liabilities resulting from same is the sole responsibility of the property owner.

I have read and fully understand the above provisions and agree to comply by said provisions.

Harold McDaniel 6-7-90  
APPLICANT(S) SIGNATURE

\*\*\*\*\*


INSPECTOR TIM

Date inspected 6-23-90 Approved ✓ Rejected \_\_\_\_\_  
Reason for rejection \_\_\_\_\_

Date reinspected \_\_\_\_\_ Approved \_\_\_\_\_ Rejected \_\_\_\_\_

Notes:

Size Pipe 6"  
Type Pipe PVC  
Basement Yes \_\_\_\_\_ No ✓  
Sump Pump Yes \_\_\_\_\_ No ✓  
Downspout to Ground Yes ✓ No \_\_\_\_\_  
Septic Tank Pumped & filled Yes ✓ No \_\_\_\_\_  
Contractor Tom Davis  
Special Conditions Davis made tap used 6" saddle tap.

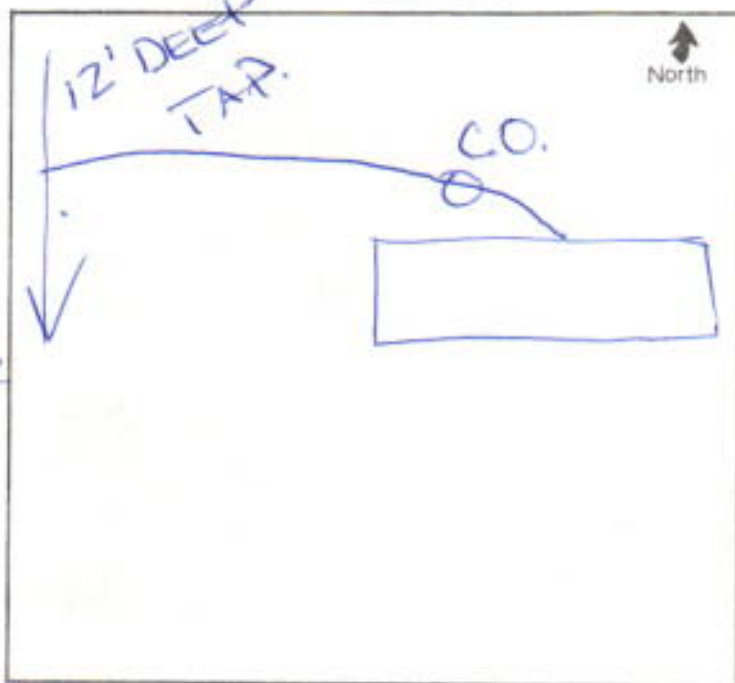

5.25-90  
EARL DAVIS

2<sup>ND</sup> & MAIN FOLD

EAST OF BANK

SOUTH OF BANK

MH 97 @ BANK 6' DEEP

.5% Slope 545'

SOUTH 98 11' DEEP MH 98

lots owned by Aaron T.

---

RECORDED      PITH-STEPHENSON  
644-4479

TOM DAVIS      \$250