


Gidw.

PROJECT Phase II SHEET _____ OF _____

SUBJECT _____ DATE 4-11-18

JOB NO. 4447

BY Atlas

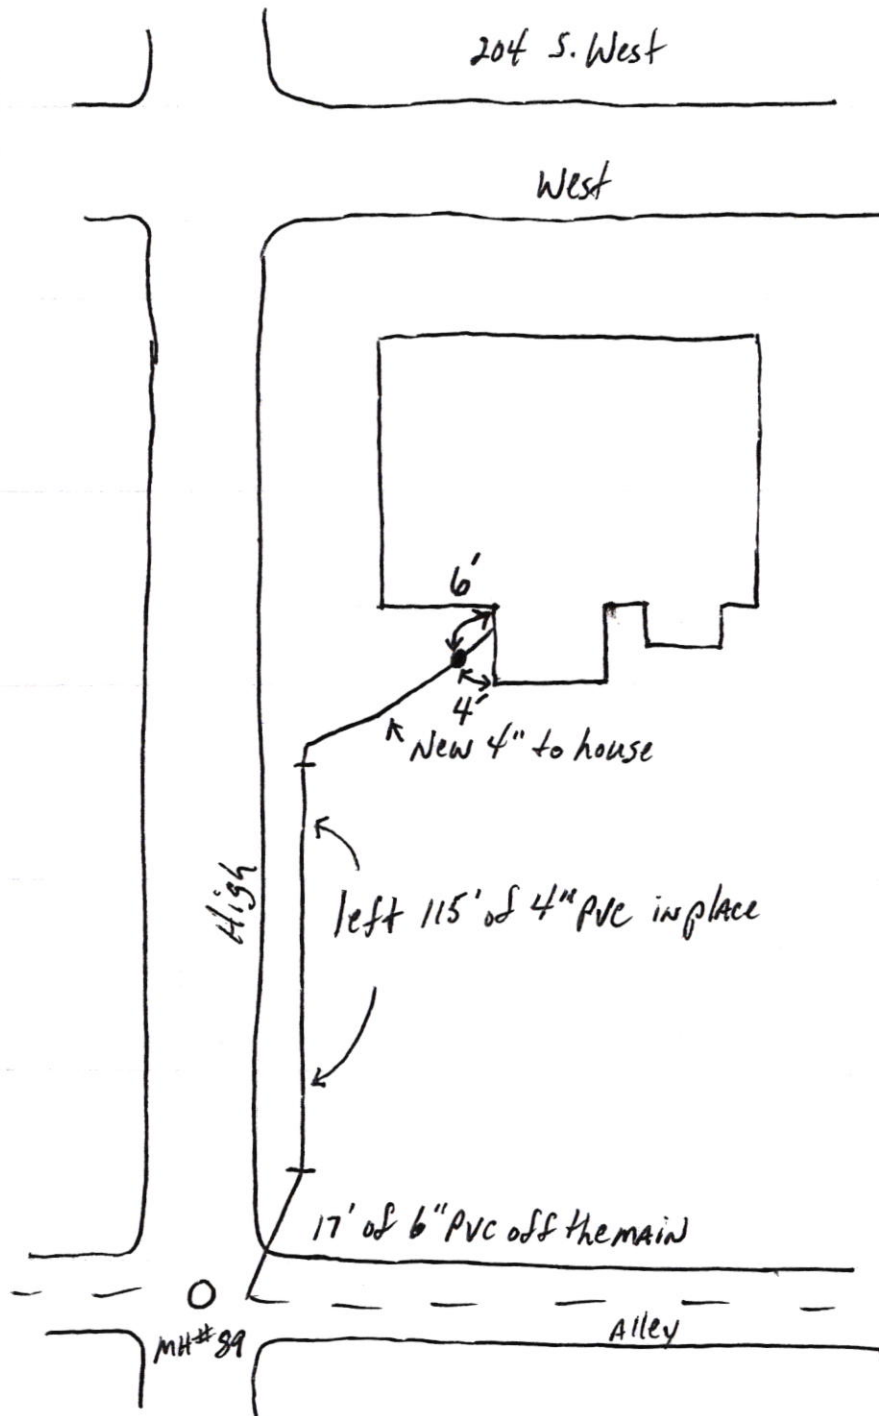

204 S West

SRF
Phase II

4.20.18

