


206 JEFFERSON

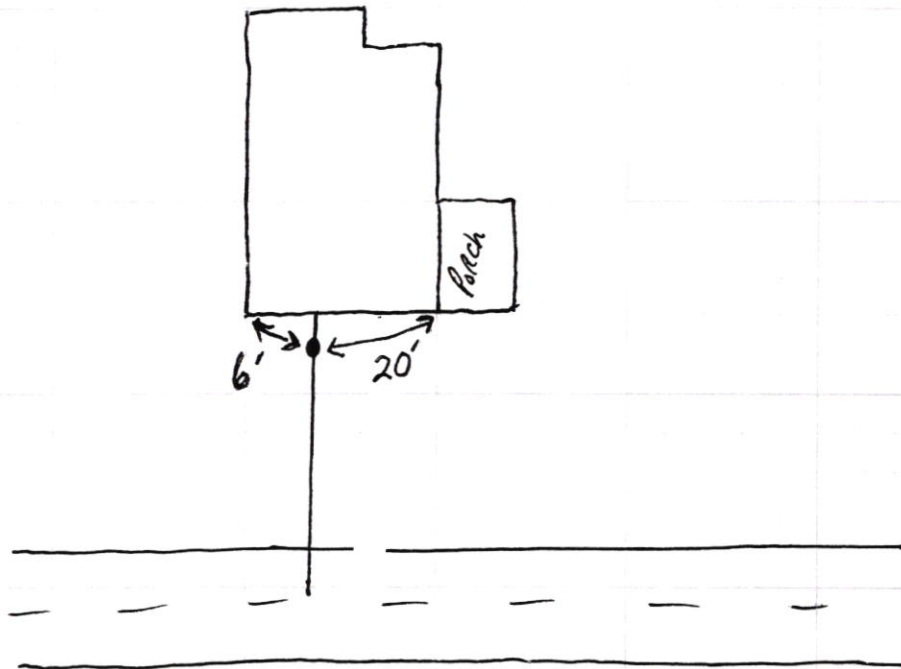

206 S Jefferson

SRF
Phase II

4.11.18

