
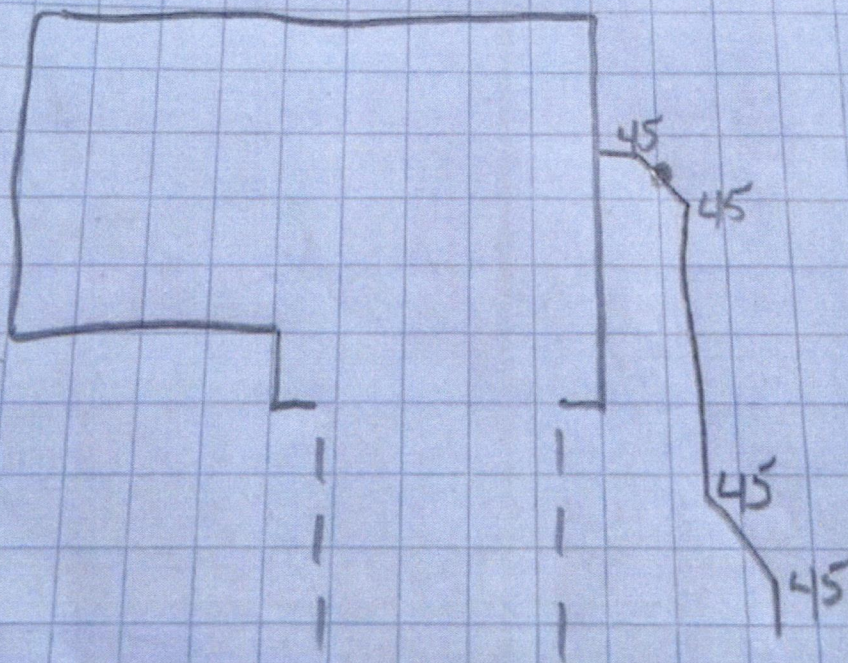


North 

Drawing
+
1 picture
attached

Maplewood Huntzingers
Lot 171 206 winding Brookway
5/15/24 Dr. Watson



206 Winding Brook Way

Lot # 171

