

Gidw.

PROJECT Phase II SHEET _____ OF _____


SUBJECT _____ DATE 4-5-18

JOB NO. 4447

BY FCRWD

207 E. MADISON

N
↓

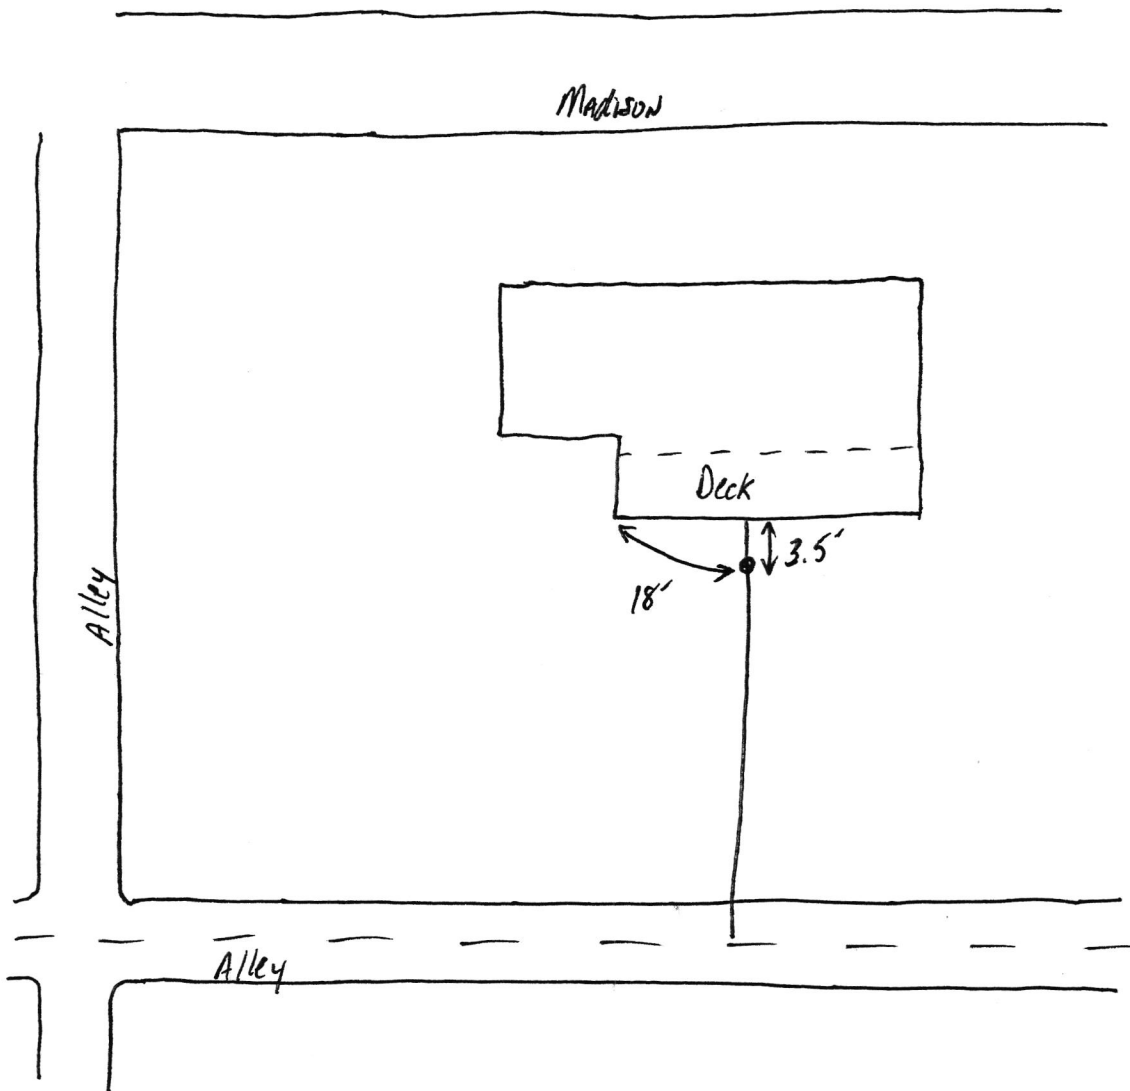

don & madison

SAT Phase II

5.22.18

