

Gidw.

PROJECT Phase II SHEET _____ OF _____


SUBJECT _____ DATE 5-9-18

JOB NO. 4447

BY ALIAS

207 W. State

215

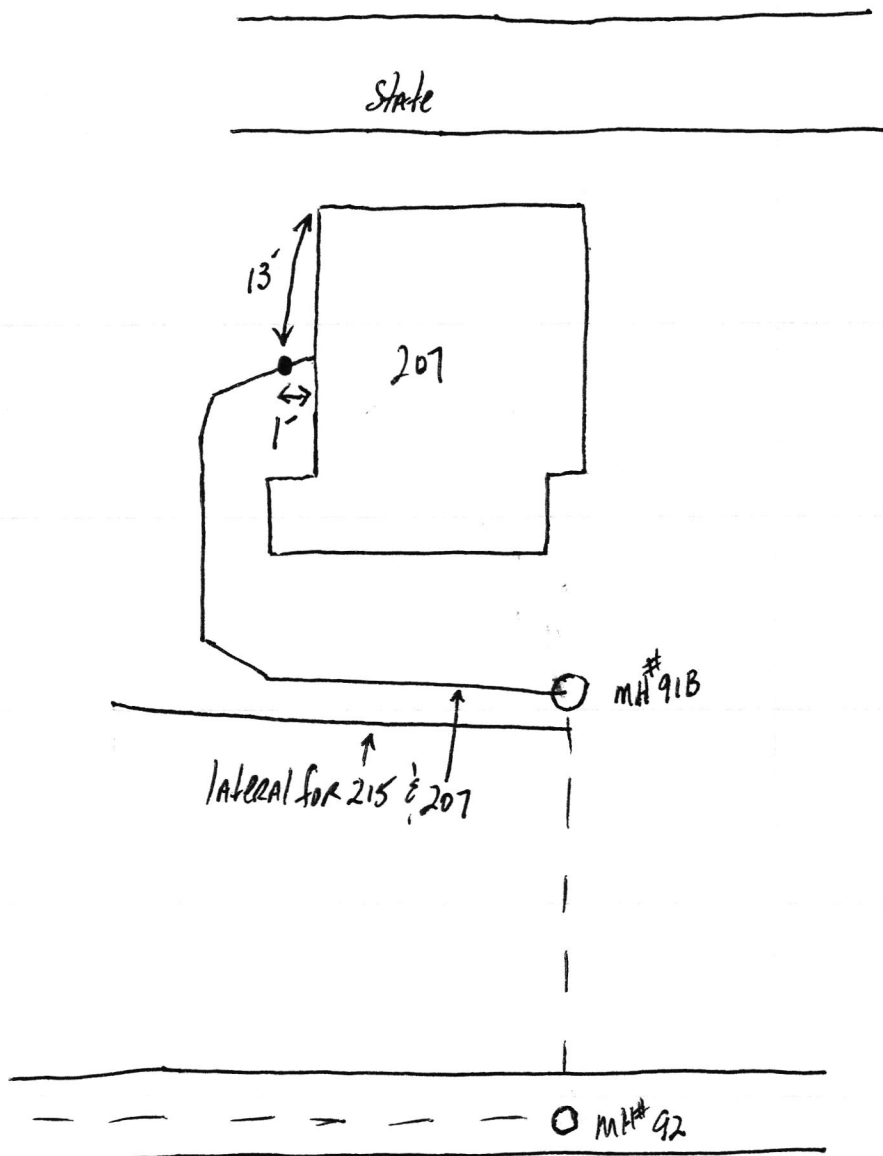

207 W. State

SPT Phase II

5-14-18

