

Gidw.


PROJECT Phase II SHEET _____ OF _____

SUBJECT _____ DATE 6-14-18

JOB NO. 4447

BY Atlas

208 E. Indiana

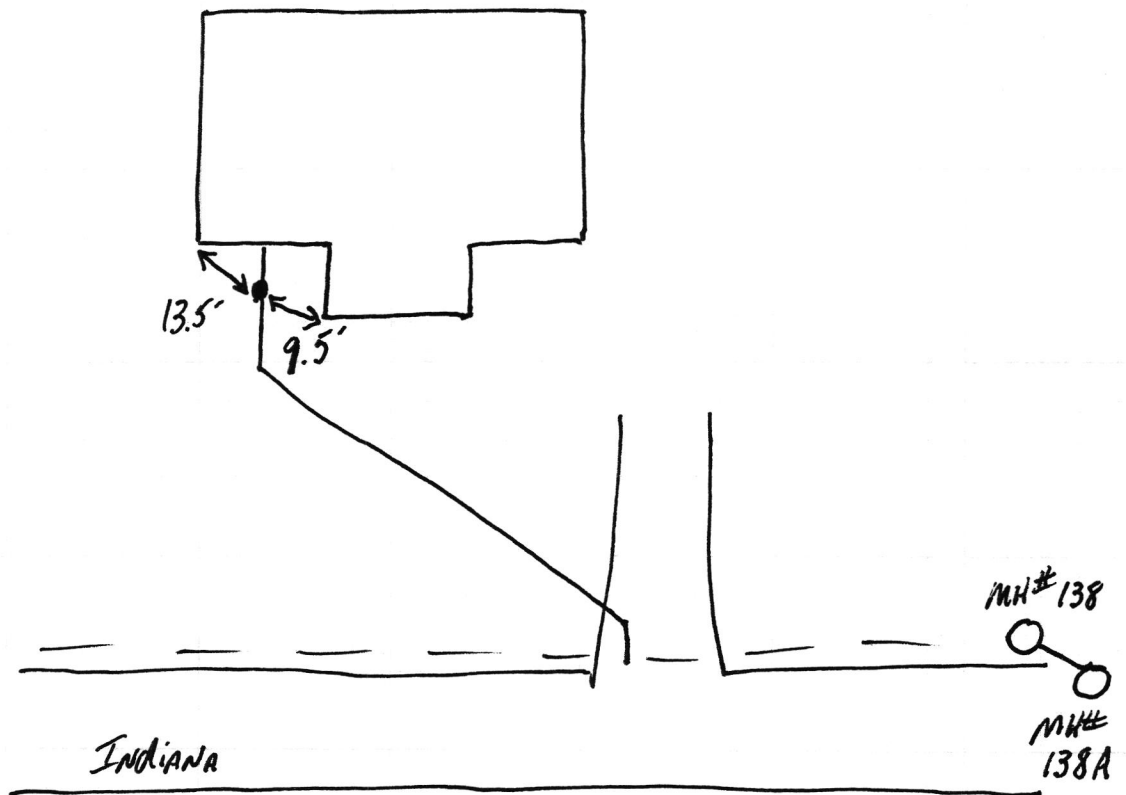



2028 Indiana

SAC Phase II

02.19.18