

Gidw.


PROJECT Phase II SHEET _____ OF _____

SUBJECT _____ DATE 6-14-18

JOB NO. 4447

BY Atlas

209 E. Indiana

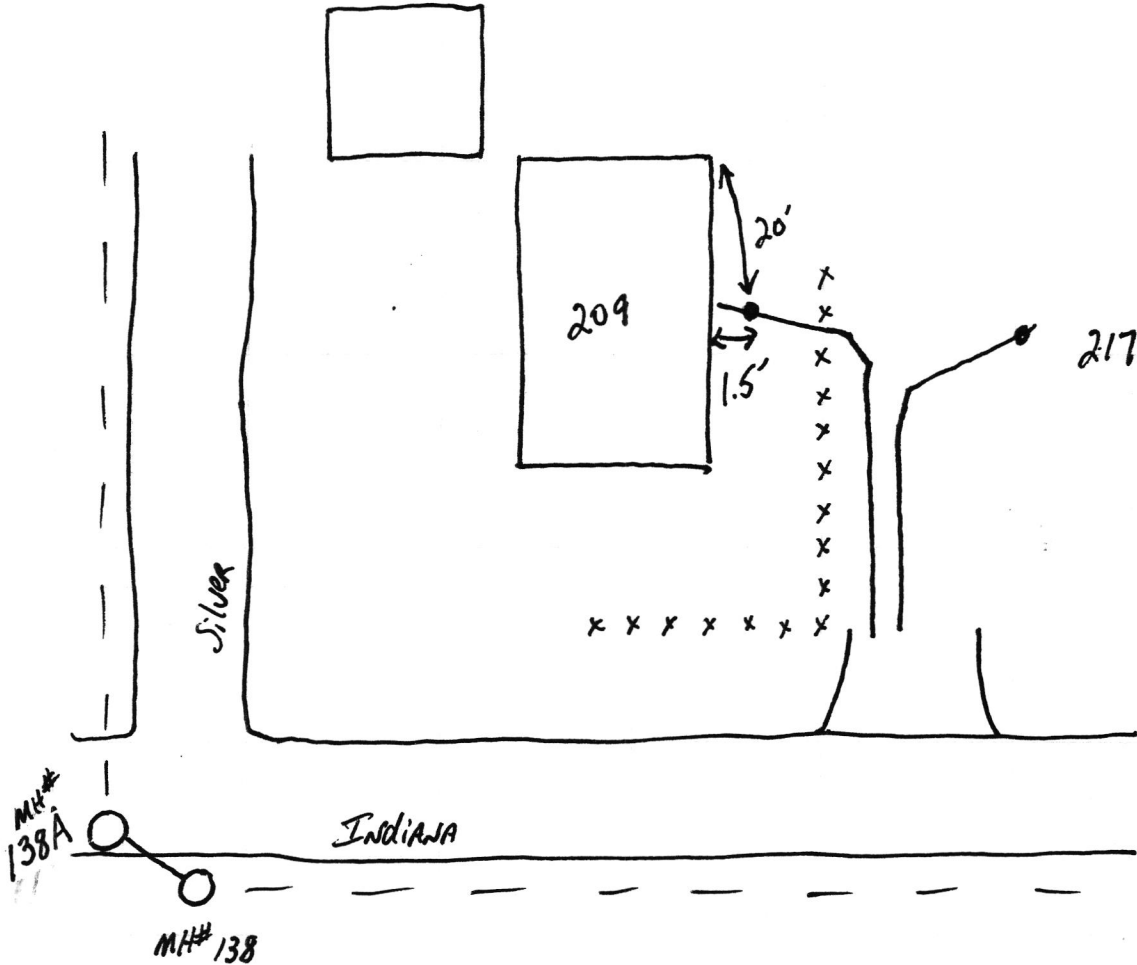

lateral for 209 runs down 217 driveway
laterals in the same ditch

209 Indiana

SHE Phase II

6.19.18

