


Gidw.

PROJECT Phase II SHEET _____ OF _____

SUBJECT _____ DATE 2-16-18

JOB NO. 4447

BY ATLAS

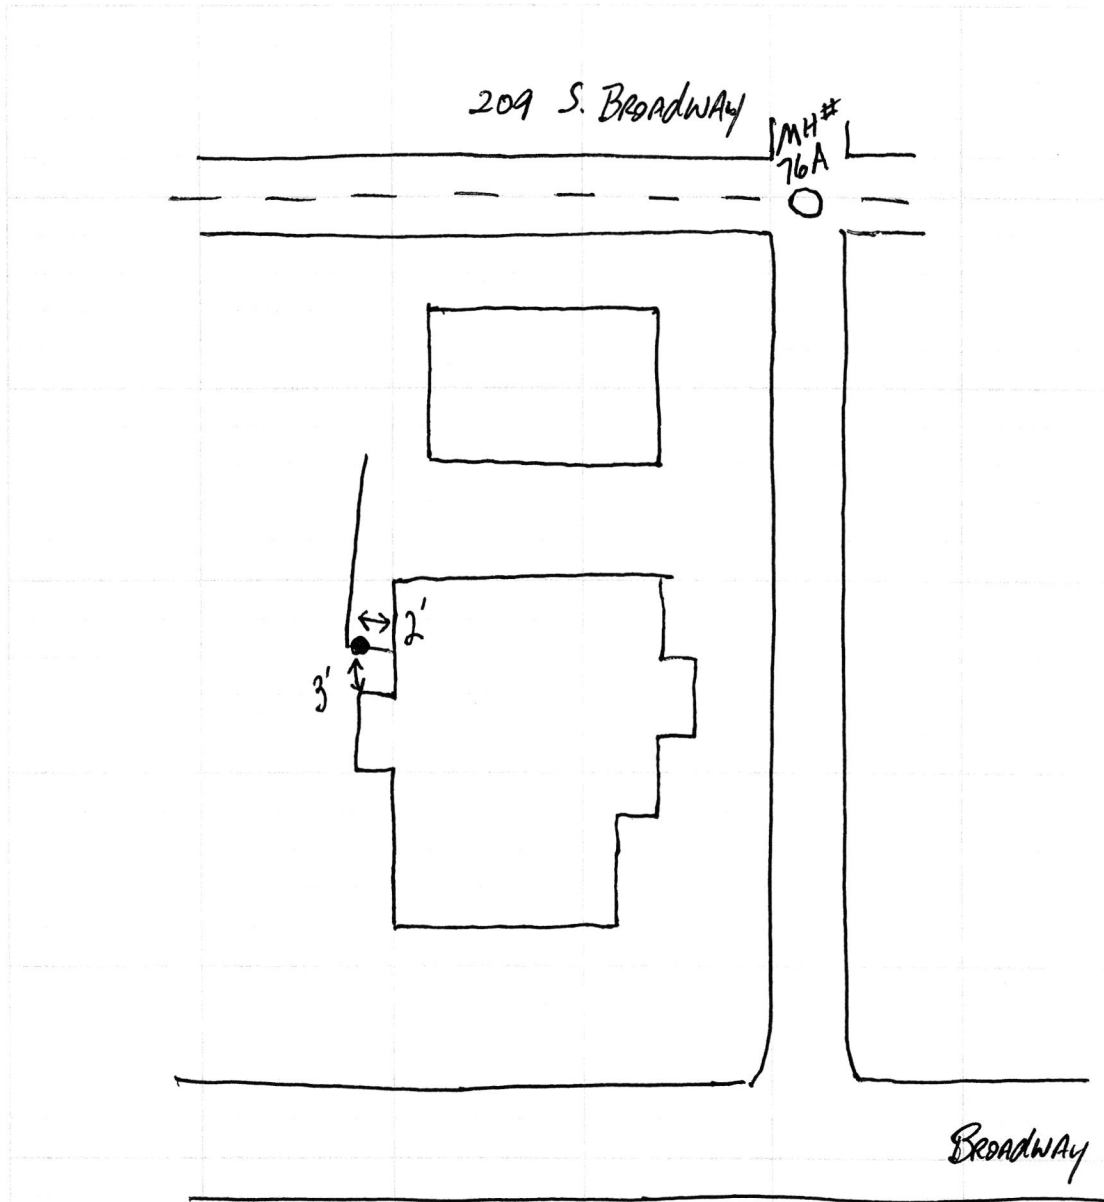

209 S Broadway

SRP Phase II

2018

