

Gidw.

PROJECT Phase II SHEET _____ OF _____


SUBJECT _____ DATE 4-27-18

JOB NO. 4447

BY ALIAS

209 S. Main

_____ Main _____

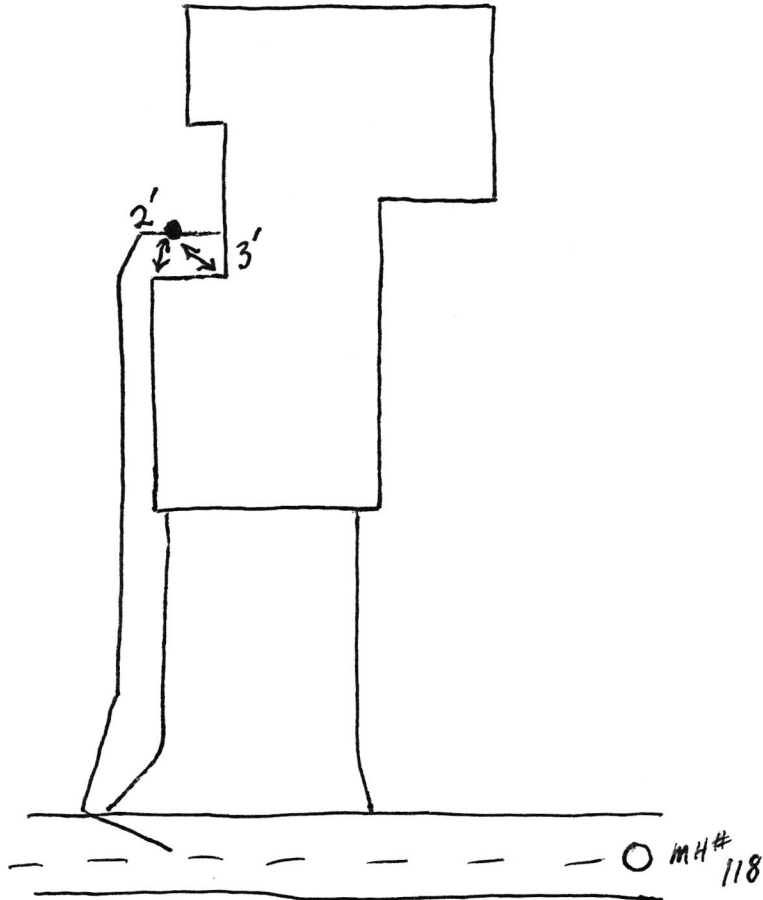

209 S main

SRF
Phase II

5.3.18



