








Lot 111 Huntzingers 2105 maplewood LN Driveway 3-29-22

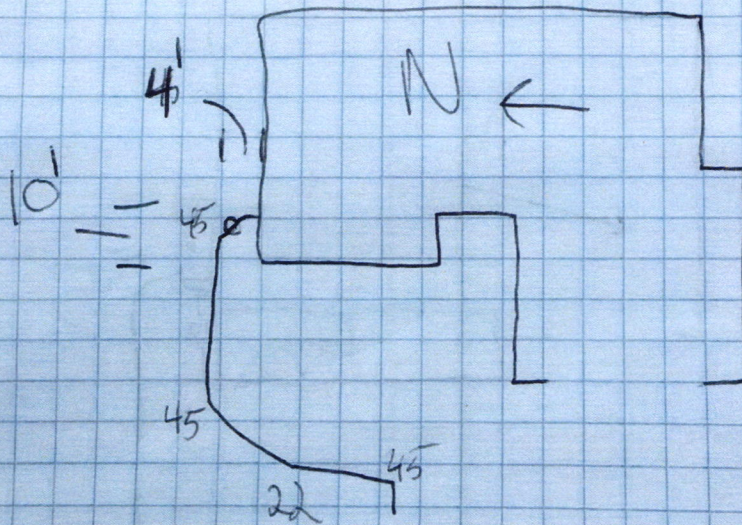

Lot 112 Huntzingers 2121 maplewood LN Driveway 3-29-22.







