

Gidw.

PROJECT Phase II SHEET _____ OF _____

SUBJECT _____ DATE 6-18-18

JOB NO. 4447


BY Atlas

210 E. Clark

← N

220

laterals for 210 & 220
in the same trench

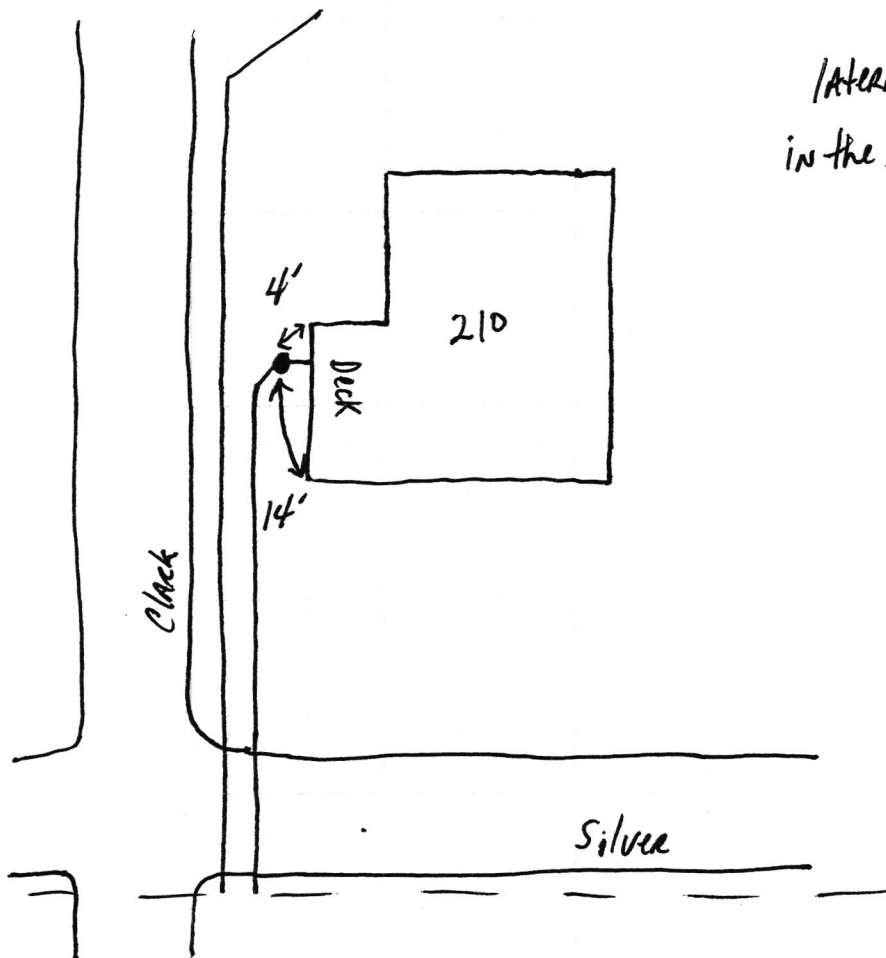

aid Clarke

S&P phase II

6.19.18

