


GRW.

PROJECT Phase II SHEET _____ OF _____
SUBJECT _____ DATE 7-12-18
JOB NO. 4447
BY Atlas

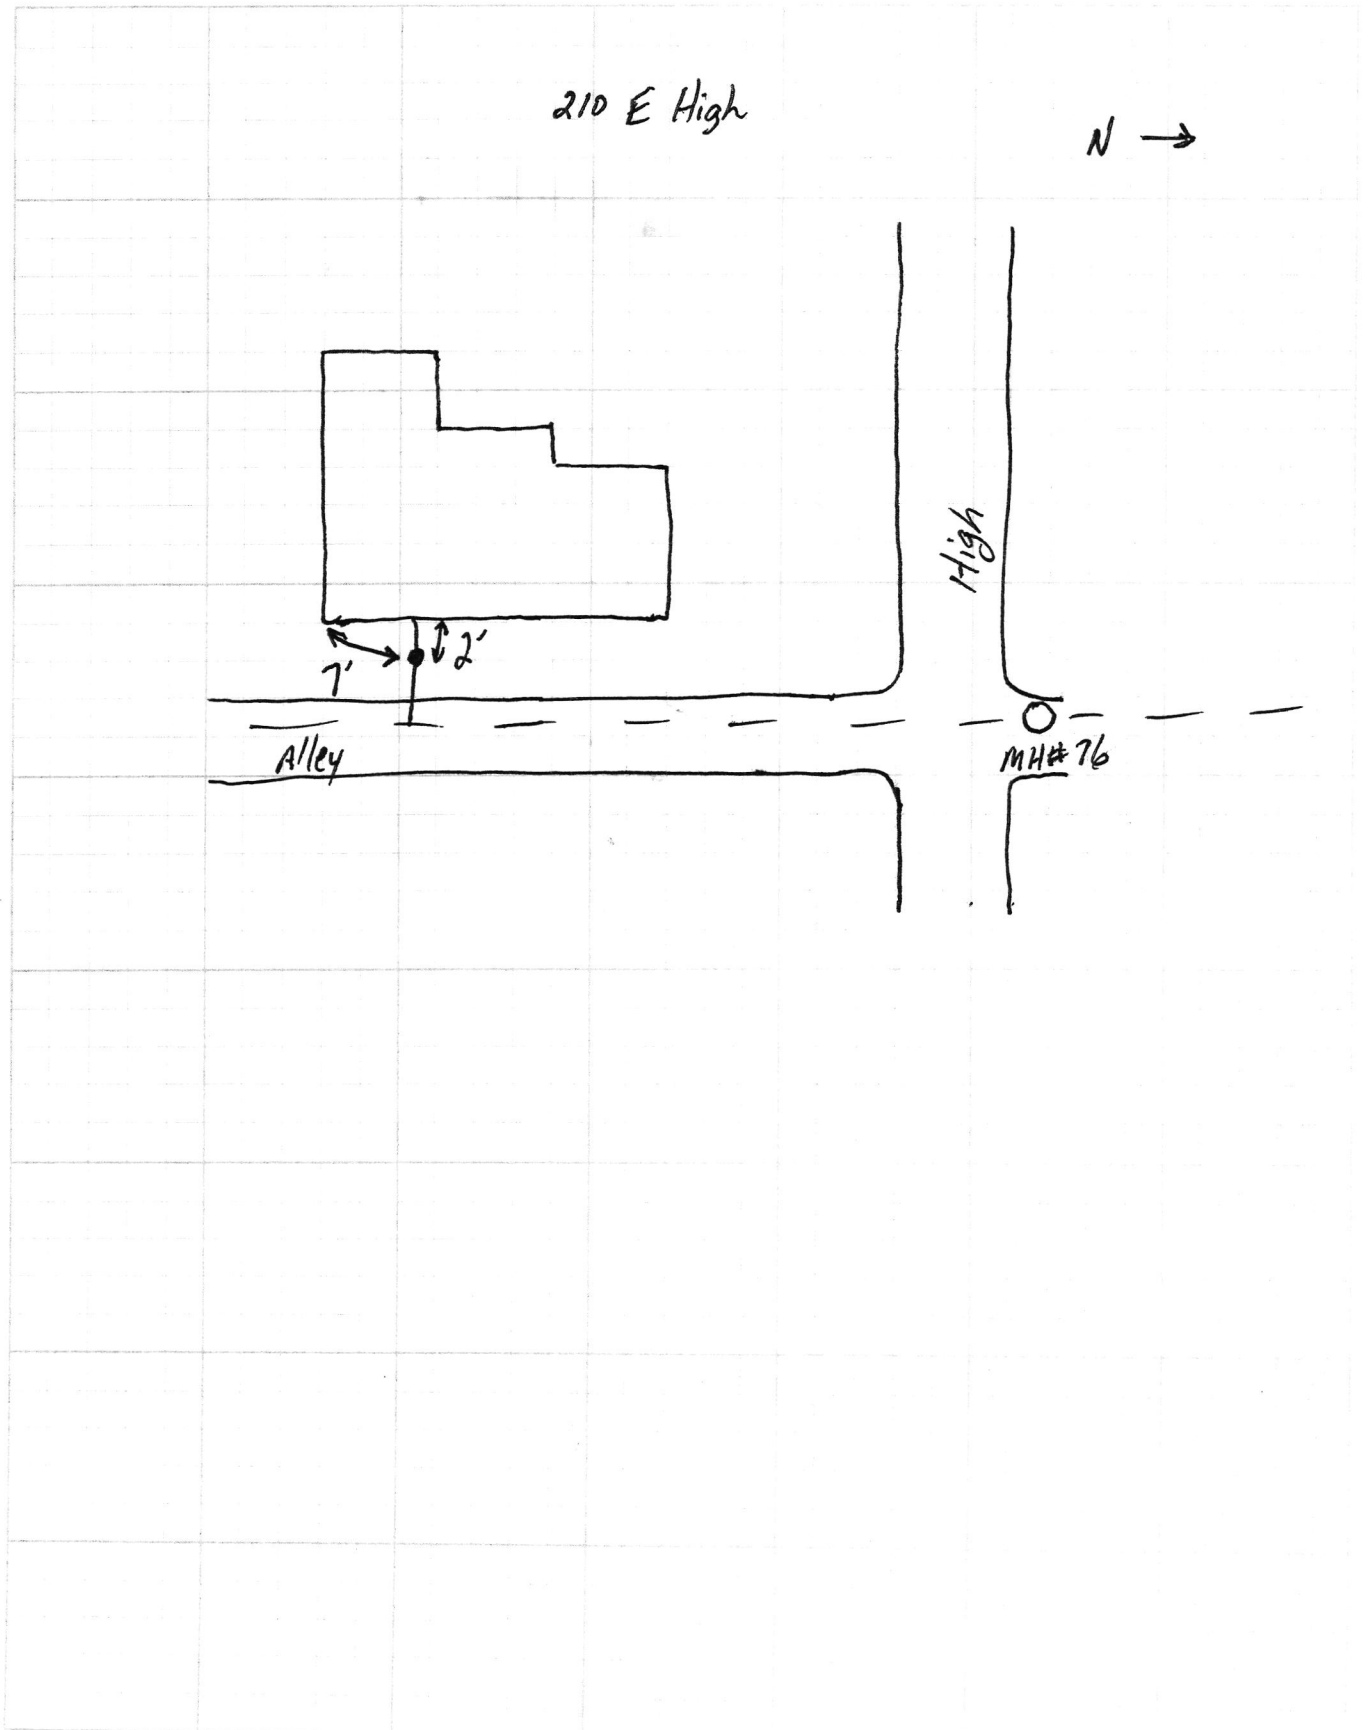

210 E High

SRF Phase II

7.18.18

