

Gidw.


PROJECT Phase II SHEET _____ OF _____

SUBJECT _____ DATE 2-2-18

JOB NO. 4447

BY Atlas

210 E. State

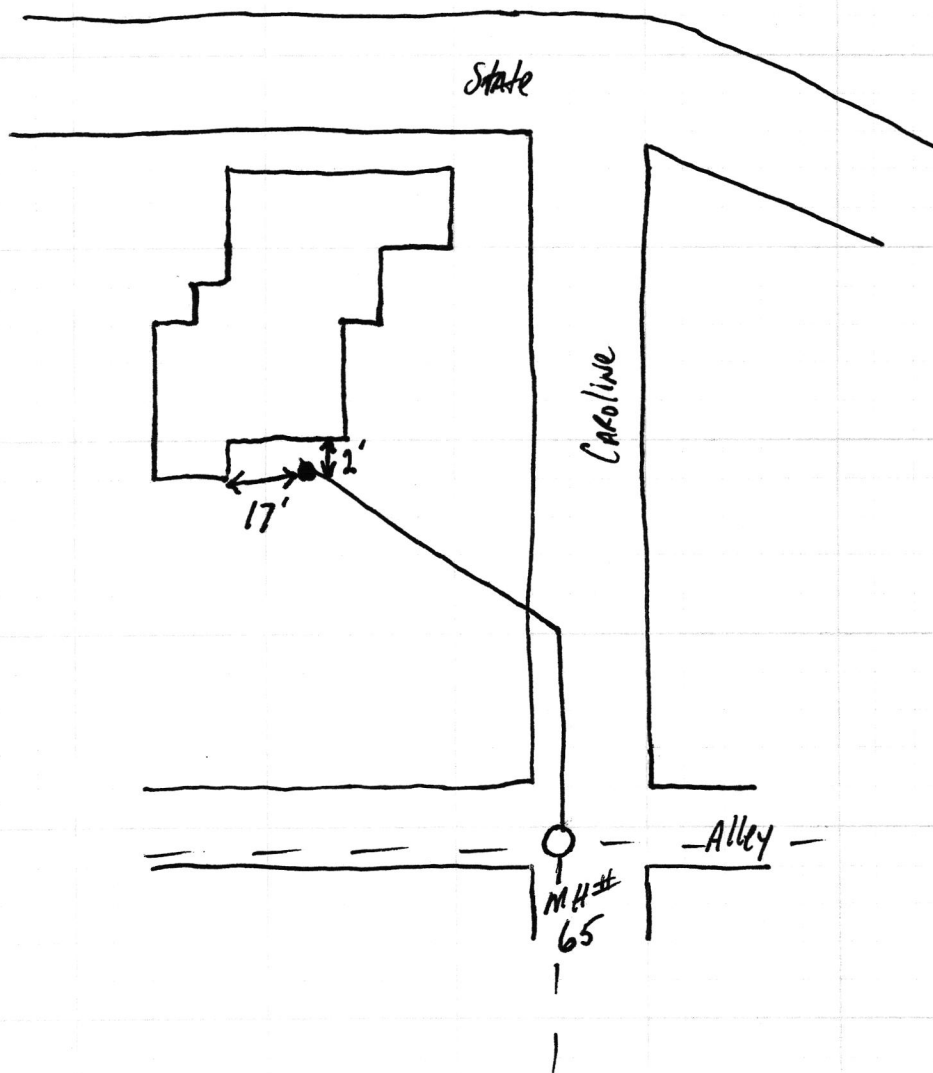

210 E State ST

SRF Phase II

2018

