

**Gidw.**

PROJECT Phase II SHEET \_\_\_\_\_ OF \_\_\_\_\_


SUBJECT \_\_\_\_\_ DATE 7-24-18

JOB NO. 4447

BY Atlas

210 J. Pearl

↑  
N

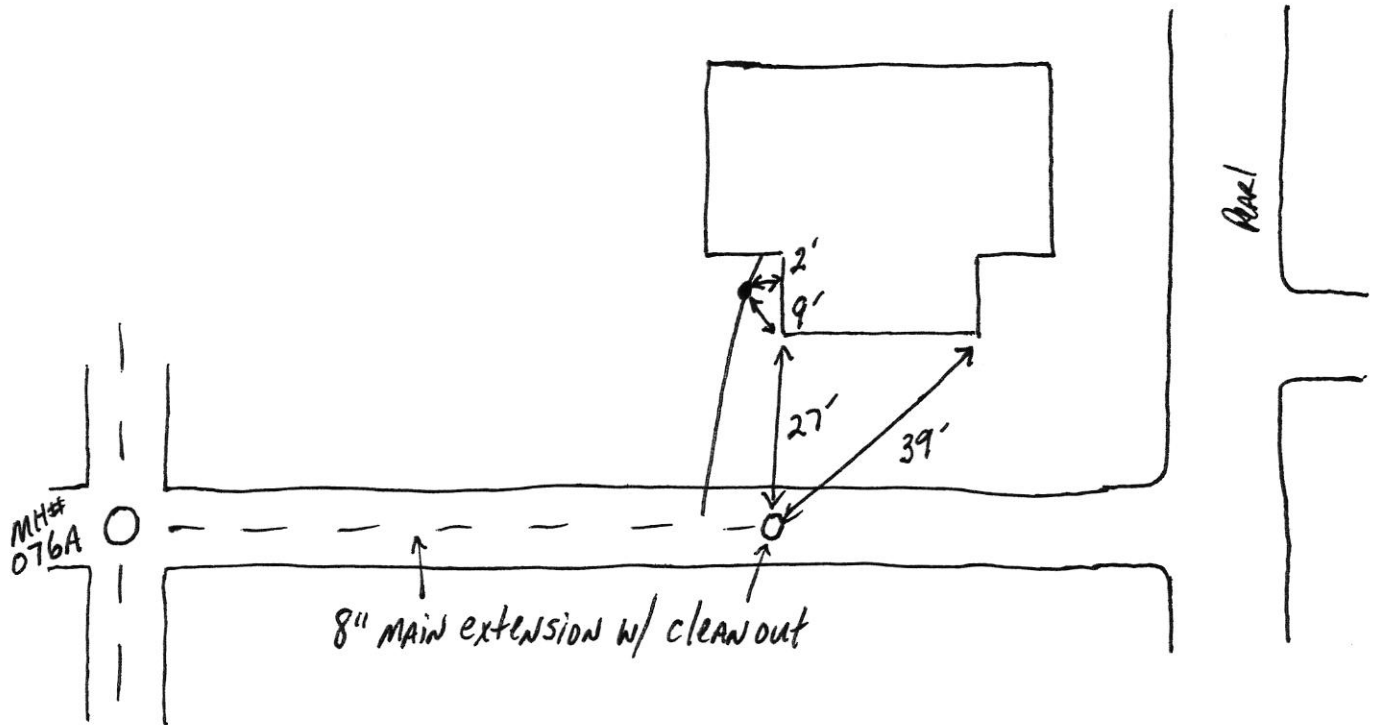

aid Bear 1

SRE Phase II

7.30.18

