

Gidw.

PROJECT

Phase II

SHEET

OF

SUBJECT

DATE 3-23-18

JOB NO.


4447

BY


Atlas

210 S. Adams

Adams

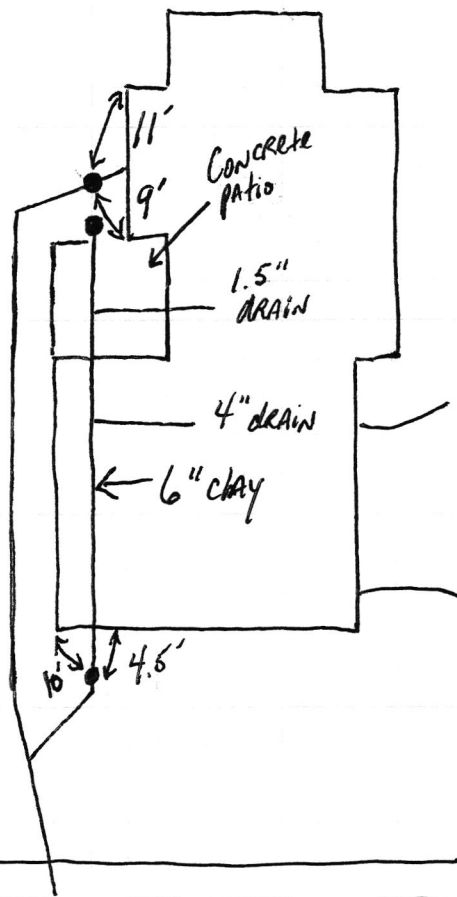

6" clay left in
place under concrete
patio & house & garage

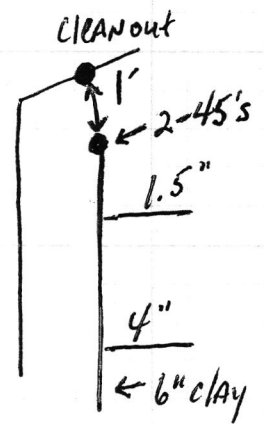

Alley

Alley

210 S Adams

SRF Phase II



210 S Adams

SRF Phase II



210 S Adams

SRP Phase II





