

Gidw.

PROJECT

Phase II

SHEET

OF

SUBJECT

DATE

4-10-18

JOB NO

4447


BY

Atlas

210 S. Broadway

Broadway

Tim-replace
original with this
one

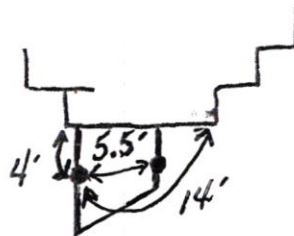

Alley


Gidw.

PROJECT Phase II SHEET _____ OF _____

SUBJECT _____ DATE 4-10-18

JOB NO. 4447

BY Atlas

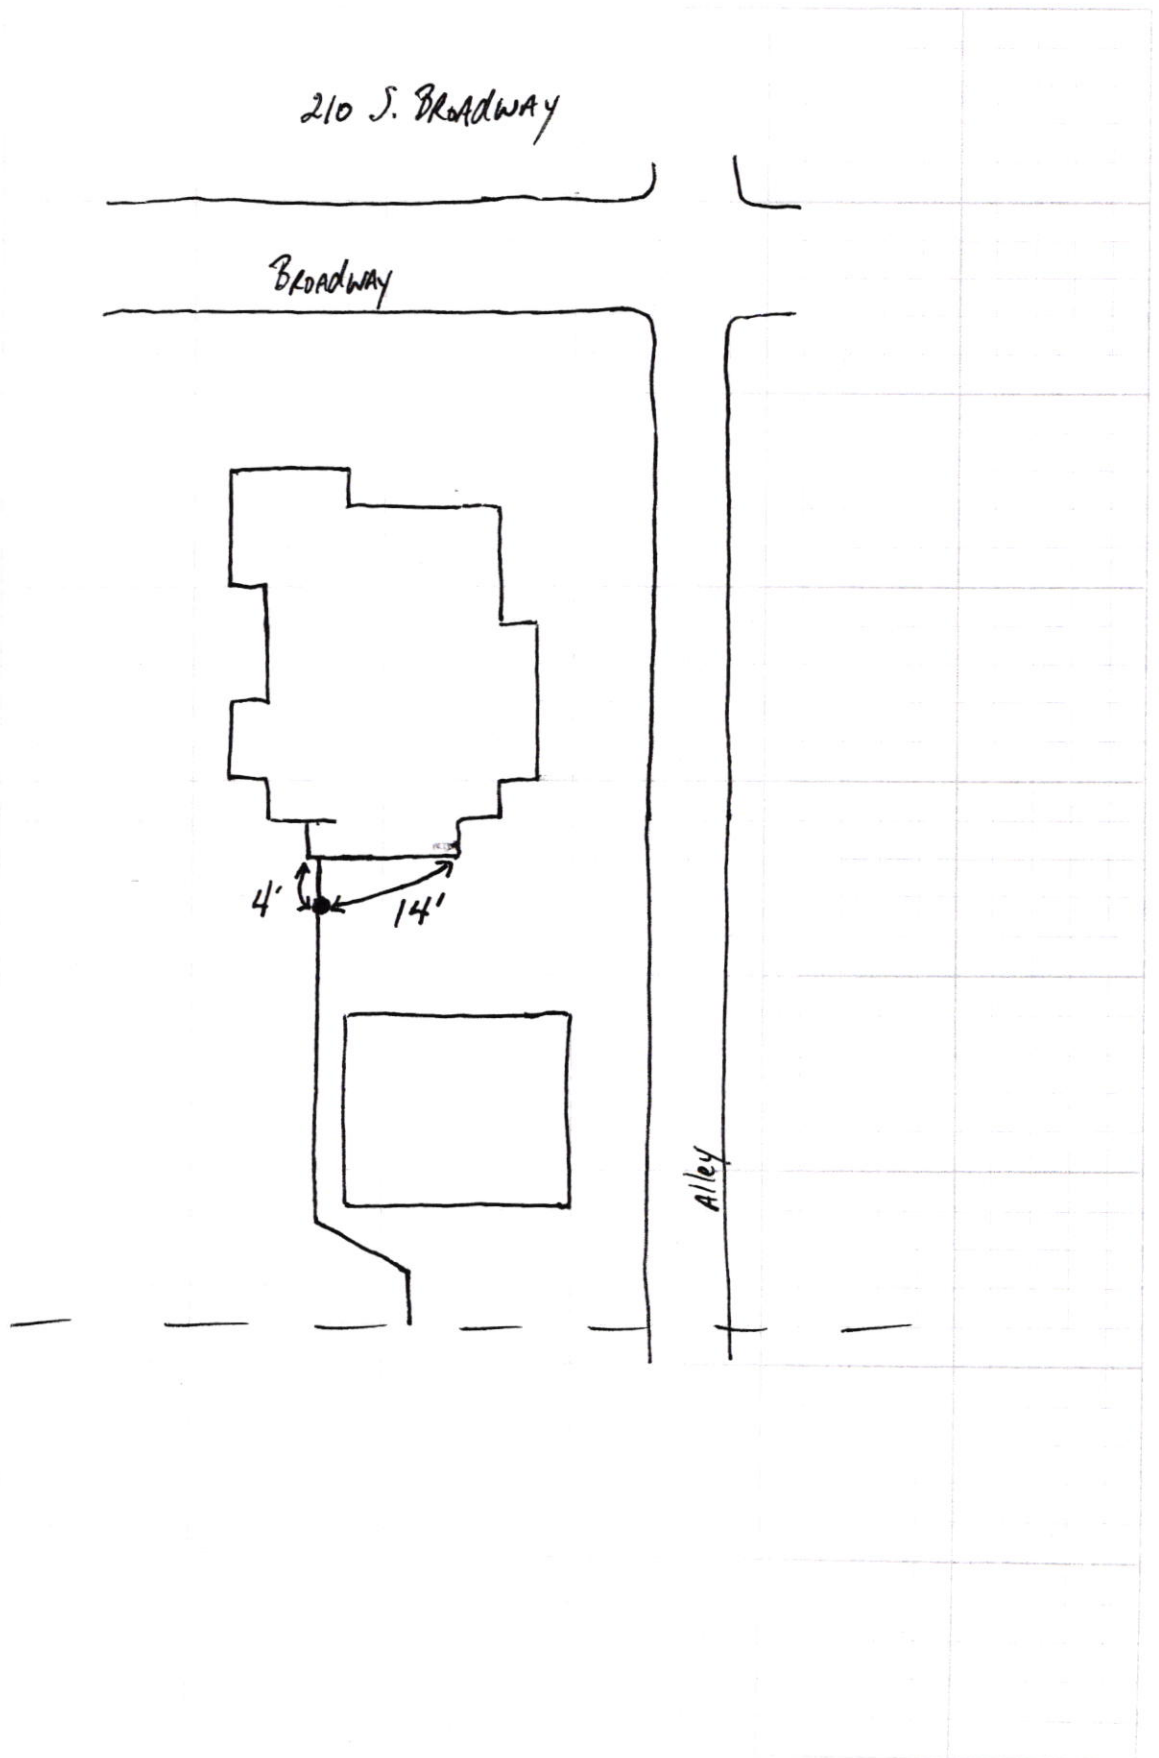

210 S Broadway

SRF
Phase II

4-20-18



210 S Broadway

SRP
Phase II

4.11.18

