


Gidw.

PROJECT Phase II SHEET _____ OF _____
SUBJECT _____ DATE 3-28-18
JOB NO. 4447
BY Atlas



210 S West SRP Phase II

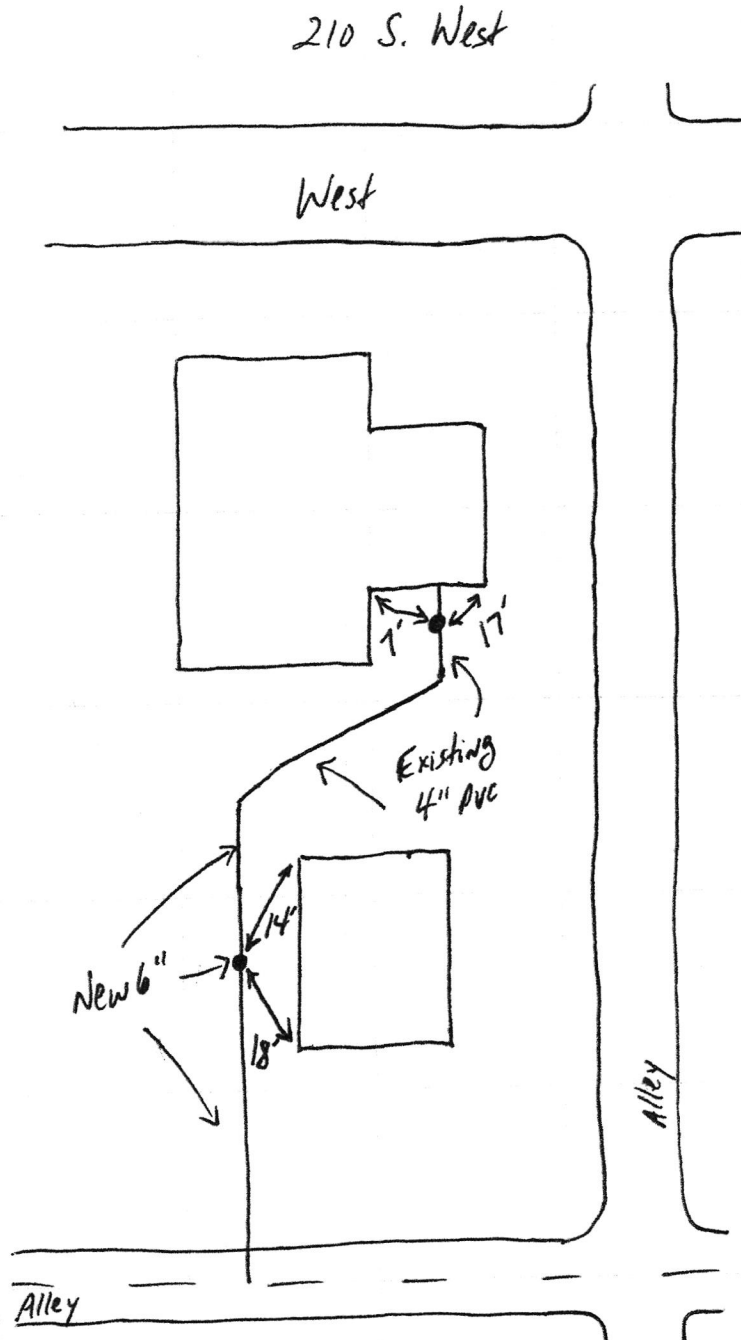

210 S West

SRP Phase II

