

9-19444.00

4802

FALL CREEK REGIONAL WASTE DISTRICT

9378 S 650 WEST, P.O. BOX 59, PENDLETON, IN 46064

765-778-7544

AGREEMENT FOR SANITARY SEWER SERVICE

This Agreement made and entered into this 2nd day of April, 2003, between FALL CREEK REGIONAL WASTE DISTRICT ("District") and Don + Danielle Corya ("Applicant") regarding the provision of sanitary sewer service, and the assignment of capacity in, and connection to, the District's facilities for the premises located at 211 Danci Drive, Pendleton

NOW THEREFORE, the parties, in consideration of the mutual promises set out in this Agreement, the receipt and sufficiency of which is hereby acknowledged, agree as follows:

1. The Applicant agrees that all workmanship and materials shall conform to all District ordinances and the District's construction standards. District must accept and approve all work and materials before backfilling and final connection is made to the sewer mains. Any violation of this provision will cause all lines and appurtenances in violation to be removed and replaced at the Applicant's expense.
2. The District shall have the right to enter upon the Applicant's premises at all reasonable times to inspect, repair, or replace any equipment used in connection with the District's service or which has an impact on said service.
3. The Applicant shall be responsible for all monthly user rates, capacity charges, and tap fees. The failure to pay any rate charge or fee may result in a lien against the property and/or the termination of service to the property, the cost of which will be borne by Applicant, including, but not limited to, all attorney's fees and collection costs.
4. The District shall not be responsible for any damages as a result of any failure to supply service unless said damages are due to default, neglect or culpability on the part of the District.
5. If there is an available sanitary sewer within three hundred (300) feet of the property line, the property owner shall be required to connect to the District's sanitary sewer system.
6. The Applicant and District agree that the provision of sanitary sewer service touches and concerns the property and the terms of this Agreement bind the District and Applicant and their heirs, executors, administrators, personal representatives, successors, agents, attorneys, assigns, designees, and transferees.

The parties hereto have read and fully understand the above provisions and agree to comply with said provisions.

FALL CREEK REGIONAL WASTE DISTRICT
Libbby Wilson
Signature

APPLICANT
Danielle Corya
Signature

STATE OF INDIANA)
) SS:
COUNTY OF MADISON)

SUBSCRIBED and sworn to before me this 2nd day of April, 2003.

My Commission Expires:
2-20-2008

Signature Deborah L. Wilson

Printed Deborah L. Wilson

Notary Public
Resident of Madison County

INSPECTOR Don DATE INSPECTED 4/2/03 APPROVED ✓ REJECTED _____

REASON FOR REJECTION _____

DATE REINSPECTED _____ APPROVED _____ REJECTED _____

NOTES:
SIZE PIPE 6" PVC TYPE PIPE 6" SDR 35

BASEMENT YES NO ✓

SUMP PUMP YES NO ✓

DOWNSPOUT TO GROUND YES ✓ NO


SEPTIC TANK PUMPED & FILLED YES NO NA

CONTRACTOR Fredericks Const.

SPECIAL CONDITIONS 6" LAT/MAIN extension

EXISTING HOME _____

NEW CONSTRUCTION ✓

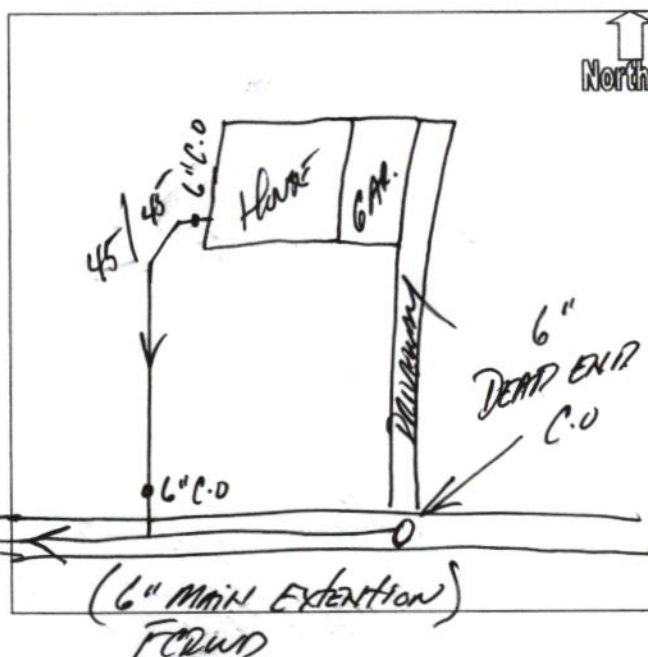

T. K. CONSTRUCTORS, INC.

5141 W. HESSLER RD.
MUNCIE, INDIANA 47304



71-167/749

Vendor No.

COR125

Check No.

119087

119087

Check Date

04/03/03

TWO THOUSAND SIX HUNDRED THIRTY FIVE DOLLARS AND 00 CENTS*****

\$2,635.00

T. K. CONSTRUCTORS, INC.
VOID AFTER 60 DAYS

Pay DON & DANIELLE CORYA &
FALL CREEK REGIONAL WASTE DIST

Mark E. Thurston MP

119087

Fall Creek Regional Waste District
9378 S 650 W
P.O. Box 59
Pendleton, IN 46064
Phone# (765) 778-7544
Fax# (765) 778-7545

Fall Creek Regional Waste District

Fax

To: <u>Judy</u>	From: <u>Libbie Wilson</u>
Fax: <u>765-282-7855</u>	Pages: <u>2</u>
Phone: _____	Date: <u>4/2/03</u>
Re: _____	CC: _____

☐ Urgent ☐ For Review ☐ Please Comment ☐ Please Reply ☐ Please Recycle



FALL CREEK REGIONAL WASTE DISTRICT

P.O. Box 59 • 9378 S. 650 West • Pendleton, Indiana 46064-0059 • (765) 778-7544

April 2, 2003

T.K. Constructors
Attn: Judy

RE: Danci Drive
Pendleton, IN 46064

Dear Judy:

Please consider this an invoice for the Tap & Capacity Fees for the new home being built on Danci Drive by your Company.

Capacity Fee	\$2160.00
Tap Fee	<u>475.00</u>
Total Due	\$2635.00

If you have any questions, please give us a call at 765-778-7544.

Sincerely,

Debbie Wilson
Assistant Office Manager