



FALL CREEK REGIONAL WASTE DISTRICT

Box 44, Pendleton, Indiana 46064

2-0012900.00

Nº 001189

APPLICATION FOR SEWER PERMIT

Permit No. _____ Date 1-14-86
Permit Void 90 days from Date of Issuance
Owner Name April L. Provost
Property Address 211 Fall Creek DR
Lot # _____ P.O. Box _____
Town ANDERSON, IN Zip Code 46013
Phone _____ Water Meter _____"
\$ 15000 Tap on Fee Paid
\$ 2500 Inspection fee paid

Application is hereby made for connection to the Fall Creek Regional Waste District Sewer System for the above listed property - Permit Type: Residential ☒, Commercial _____, Industrial _____, or Governmental/Institutional _____. User Information _____.

All workmanship and materials shall conform to the standards of the District Ordinance as described in Ordinance 84-2 and 84-3 as amended. Acceptance and approval must be made by the District inspector or his duly authorized representative before backfilling and final connection is made to the main sewer lines. Any violation of applicable regulations will cause all lines and appurtenances in violation to be removed and replaced at the owners expense.

The Fall Creek Regional Waste District is responsible for the inspection, approval of materials, and installation techniques only. All costs for materials and installation and any liabilities resulting from same is the sole responsibility of the property owner.

I have read and fully understand the above provisions and agree to comply by said provisions.

APPLICANT(S) SIGNATURE


INSPECTOR Tim

Date inspected 1-13-86 Approved ☒ Rejected _____

Reason for rejection _____

Date reinspected _____ Approved _____ Rejected _____

Notes:
Size Pipe 6"
Type Pipe PVC
Basement Yes _____ No ☒
Sump Pump Yes _____ No ☒
Downspout to Ground Yes ☒ No _____
Septic Tank Pumped & filled Yes _____ No ☒
Contractor A&A
Special Conditions _____

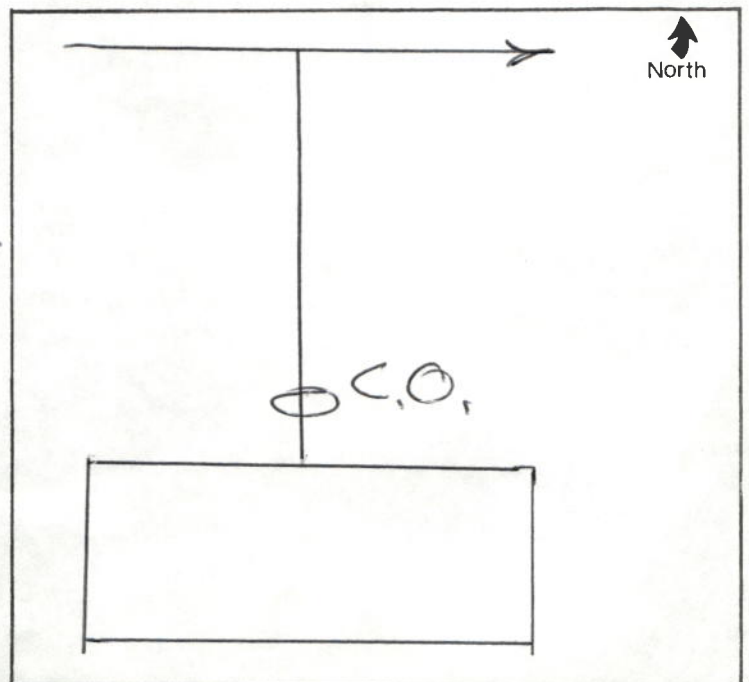

FALL CREEK REGIONAL WASTE DISTRICT

Box 44, Portland, Oregon 97201



2-001828-00

No 001828

WASTE WATER TREATMENT PLANT

1-14-82

Project Name: 1. Wastewater Treatment Plant
 Project Address: 211 Fall Creek Rd

Site: 1. Wastewater Treatment Plant
 Date: 1-14-82

Project No: 10000
 Revision: 1.0

Project Description: Wastewater Treatment Plant
 Project Location: 211 Fall Creek Rd

Project Status: 1. Wastewater Treatment Plant
 Project Owner: 1. Wastewater Treatment Plant

Project Budget: 1. Wastewater Treatment Plant
 Project Schedule: 1. Wastewater Treatment Plant

Project Risk: 1. Wastewater Treatment Plant
 Project Impact: 1. Wastewater Treatment Plant

Project Conclusion: 1. Wastewater Treatment Plant
 Project Recommendation: 1. Wastewater Treatment Plant

Project Summary: 1. Wastewater Treatment Plant
 Project Notes: 1. Wastewater Treatment Plant

Project Appendix: 1. Wastewater Treatment Plant
 Project References: 1. Wastewater Treatment Plant


Project Bibliography: 1. Wastewater Treatment Plant
 Project Glossary: 1. Wastewater Treatment Plant

Project Index: 1. Wastewater Treatment Plant
 Project Table of Contents: 1. Wastewater Treatment Plant

Project List of Figures: 1. Wastewater Treatment Plant
 Project List of Tables: 1. Wastewater Treatment Plant

Project List of Appendices: 1. Wastewater Treatment Plant
 Project List of References: 1. Wastewater Treatment Plant

Project List of Bibliography: 1. Wastewater Treatment Plant
 Project List of Glossary: 1. Wastewater Treatment Plant

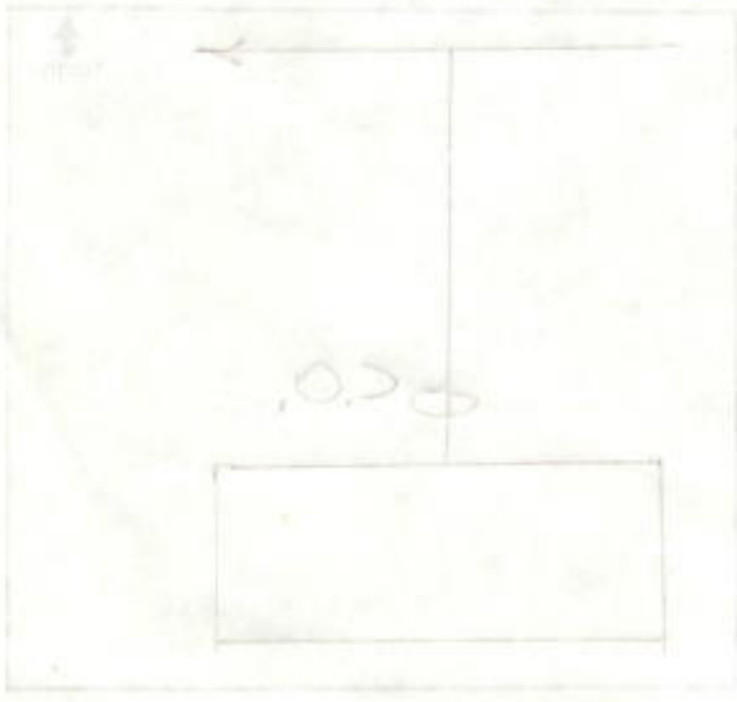

Project Name: 1. Wastewater Treatment Plant
 Project Address: 211 Fall Creek Rd
 Project Site: 1. Wastewater Treatment Plant
 Project Date: 1-14-82
 Project Revision: 1.0
 Project Description: Wastewater Treatment Plant
 Project Location: 211 Fall Creek Rd
 Project Status: 1. Wastewater Treatment Plant
 Project Owner: 1. Wastewater Treatment Plant
 Project Budget: 1. Wastewater Treatment Plant
 Project Schedule: 1. Wastewater Treatment Plant
 Project Risk: 1. Wastewater Treatment Plant
 Project Impact: 1. Wastewater Treatment Plant
 Project Conclusion: 1. Wastewater Treatment Plant
 Project Recommendation: 1. Wastewater Treatment Plant
 Project Summary: 1. Wastewater Treatment Plant
 Project Notes: 1. Wastewater Treatment Plant
 Project Appendix: 1. Wastewater Treatment Plant
 Project References: 1. Wastewater Treatment Plant
 Project Bibliography: 1. Wastewater Treatment Plant
 Project Glossary: 1. Wastewater Treatment Plant
 Project Index: 1. Wastewater Treatment Plant
 Project Table of Contents: 1. Wastewater Treatment Plant
 Project List of Figures: 1. Wastewater Treatment Plant
 Project List of Tables: 1. Wastewater Treatment Plant
 Project List of Appendices: 1. Wastewater Treatment Plant
 Project List of References: 1. Wastewater Treatment Plant
 Project List of Bibliography: 1. Wastewater Treatment Plant
 Project List of Glossary: 1. Wastewater Treatment Plant