

Gidw.

PROJECT Phase II SHEET _____ OF _____

SUBJECT _____ DATE 4-5-18


JOB NO. 4447

BY Atlas

211 Franklin

331

325

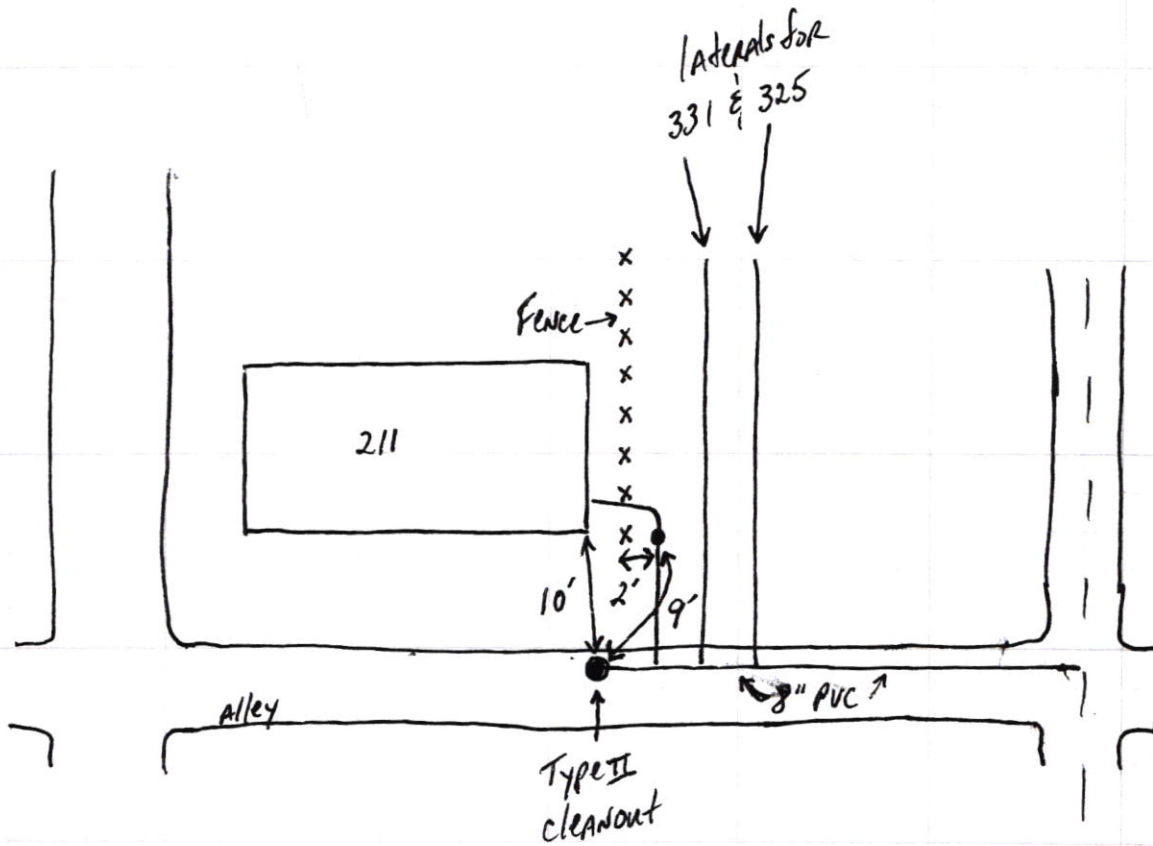

211 Franklin

SHP
Phase II

4.11.18

Type 2
Cleanout

