

Gidw.


PROJECT Phase II SHEET _____ OF _____

SUBJECT _____ DATE 4-9-18

JOB NO. 4447

BY Atlas

211 S. Jefferson

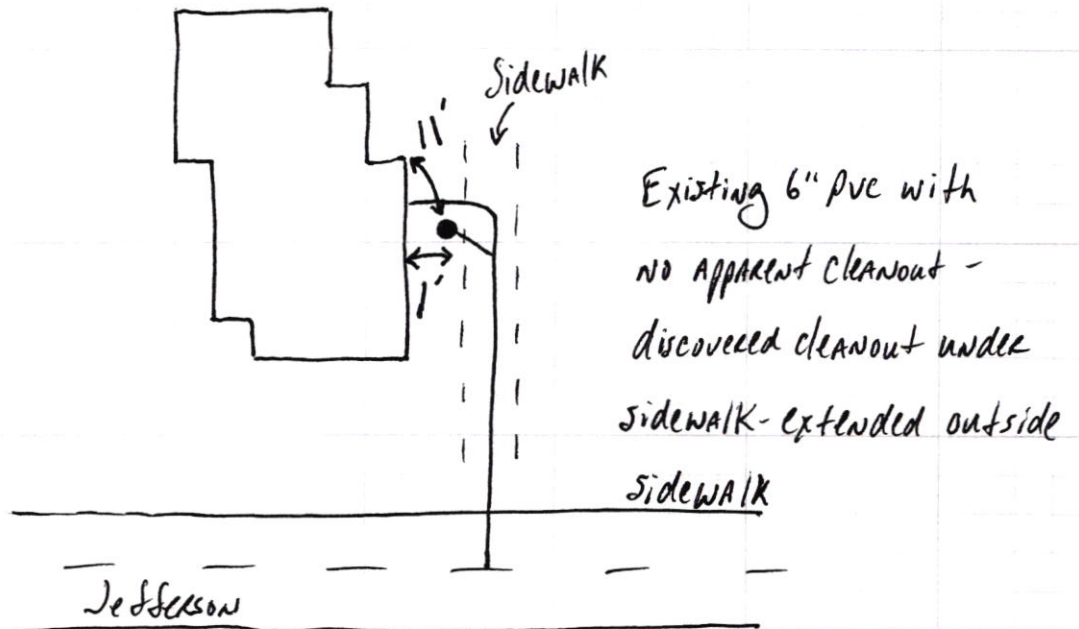

all S Jefferson

SRP
Phase II

4.11.18

