

Gidw.

PROJECT Phase II SHEET _____ OF _____

SUBJECT _____ DATE 8-6-18


JOB NO. 4447

BY Atlas

211 N. Pendleton

← N

Pendleton

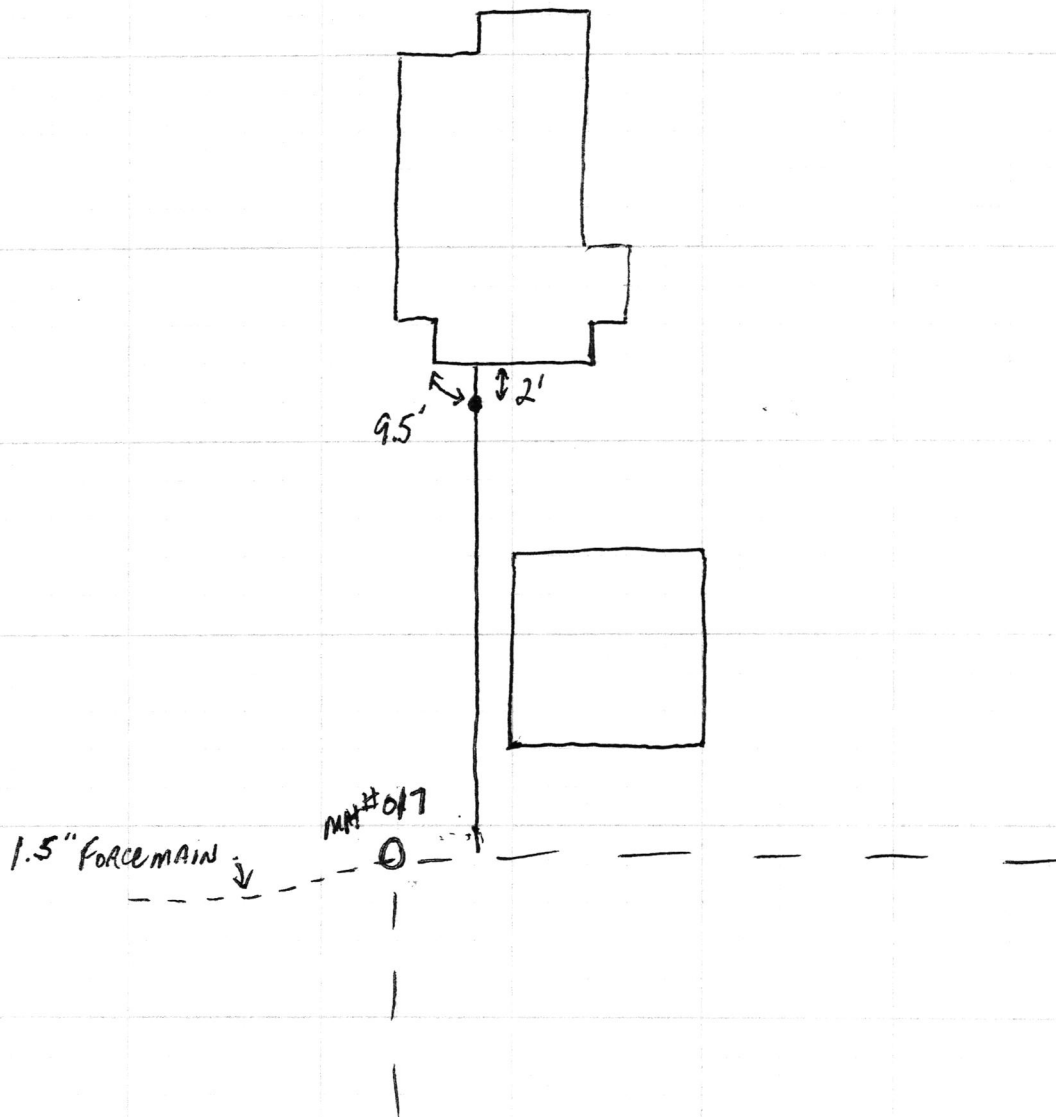

GLW


PROJECT Phase II SHEET _____ OF _____

SUBJECT _____ DATE 8-1-18

JOB NO. 4447

BY Atlas

211 Pendleton / 113 & 115 Oak / 117 & 119 Oak N →

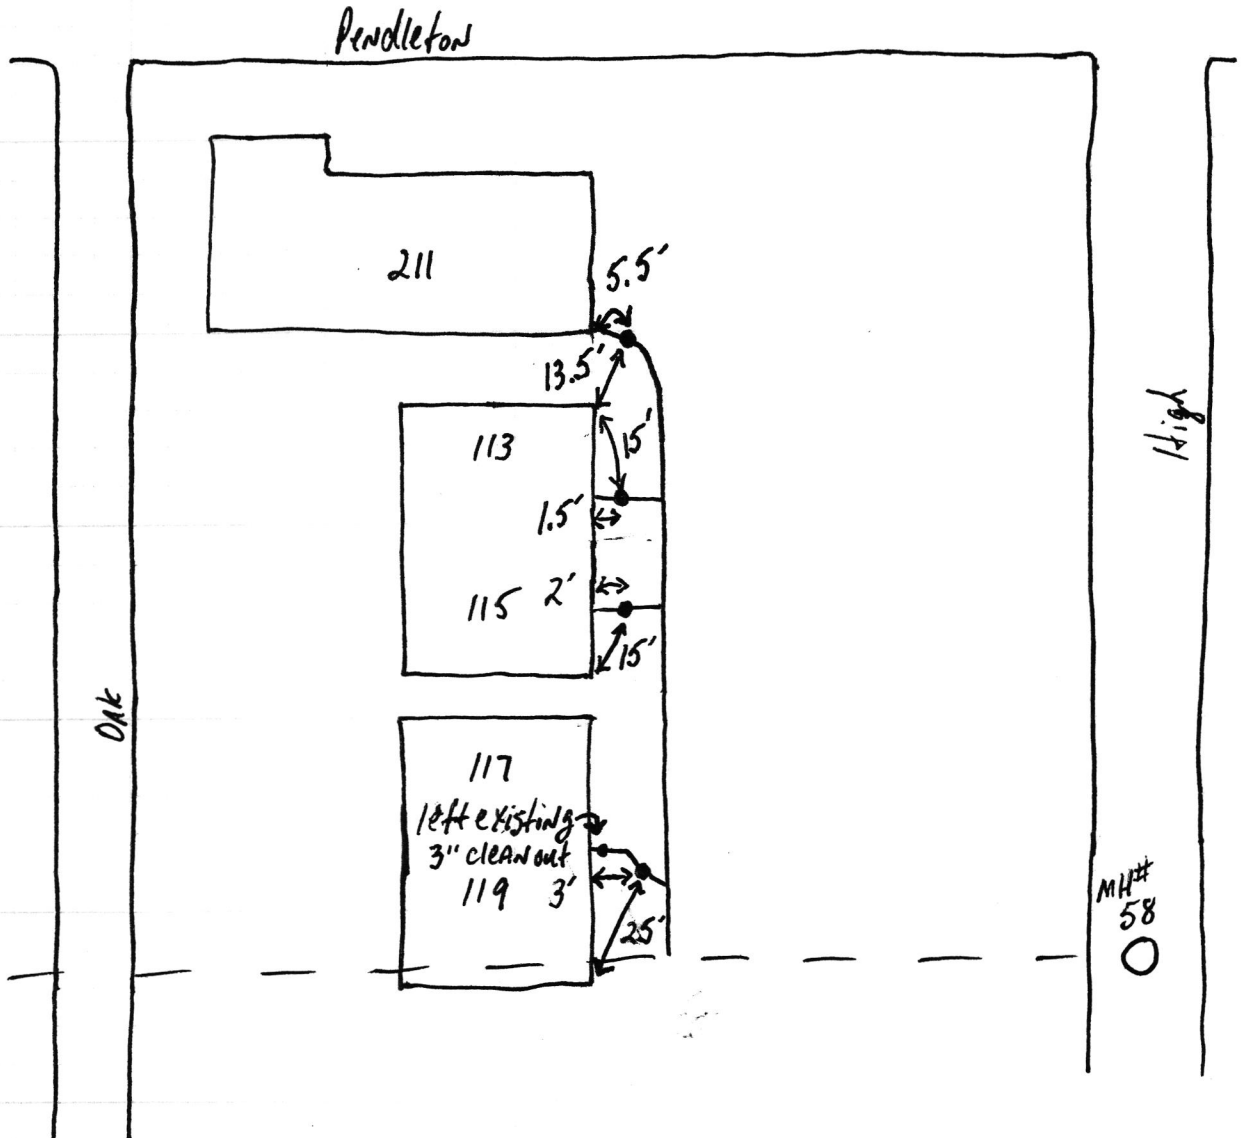

all 11 fenceposts

Site Phase II

8.15.18





8-15-18

345 phase II

8-15-18

