

Gidw.


PROJECT Phase II SHEET _____ OF _____

SUBJECT _____ DATE 3-13-18

JOB NO. 4447

BY ALIAS

211 S. Adams

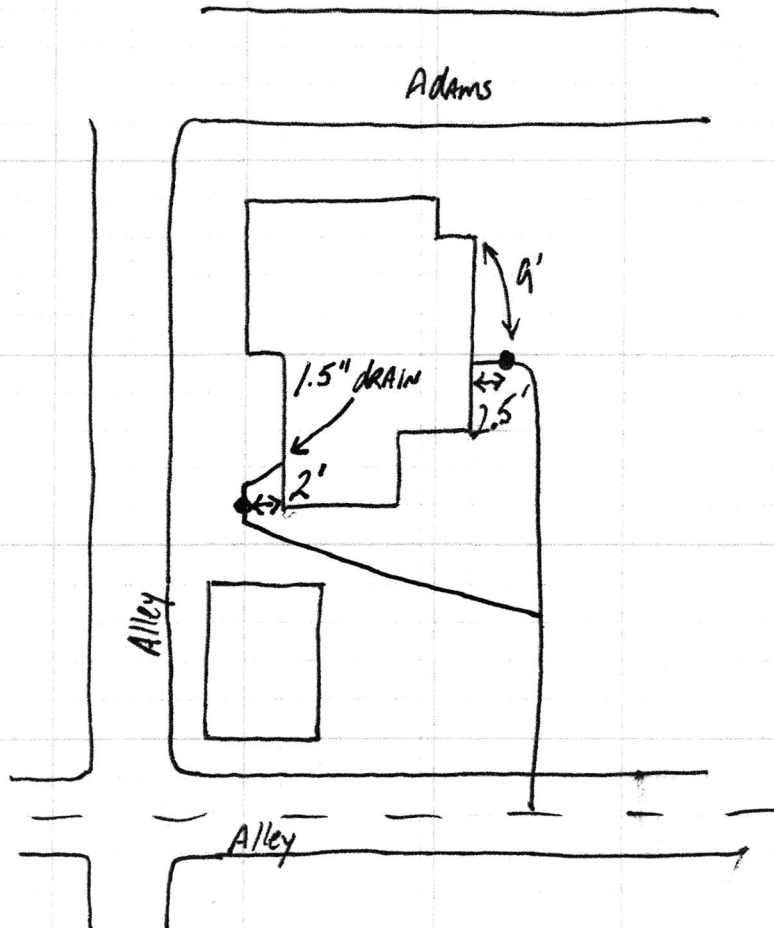

211 S Adams

SRP Phase II



211 S Adams

SFP Phase II

