


GLW

PROJECT Phase II SHEET _____ OF _____
SUBJECT _____ DATE 2-9-18
JOB NO. 4447
BY Atlas

211 W. Taylor

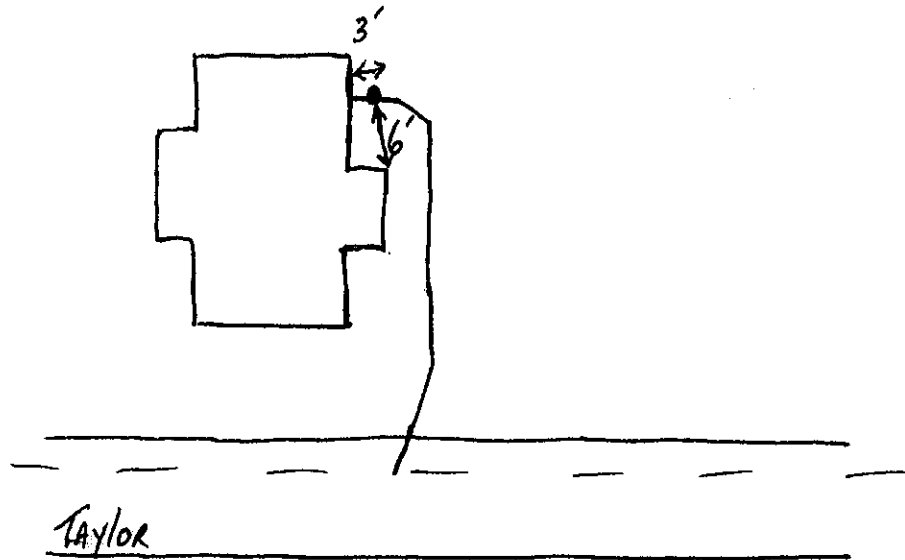

211 W Taylor

SRF Phase II

2.9.18

