


Gidw.

PROJECT Phase II SHEET _____ OF _____
SUBJECT _____ DATE 6-12-18
JOB NO. 4447
BY Atlas

212 E. Indiana

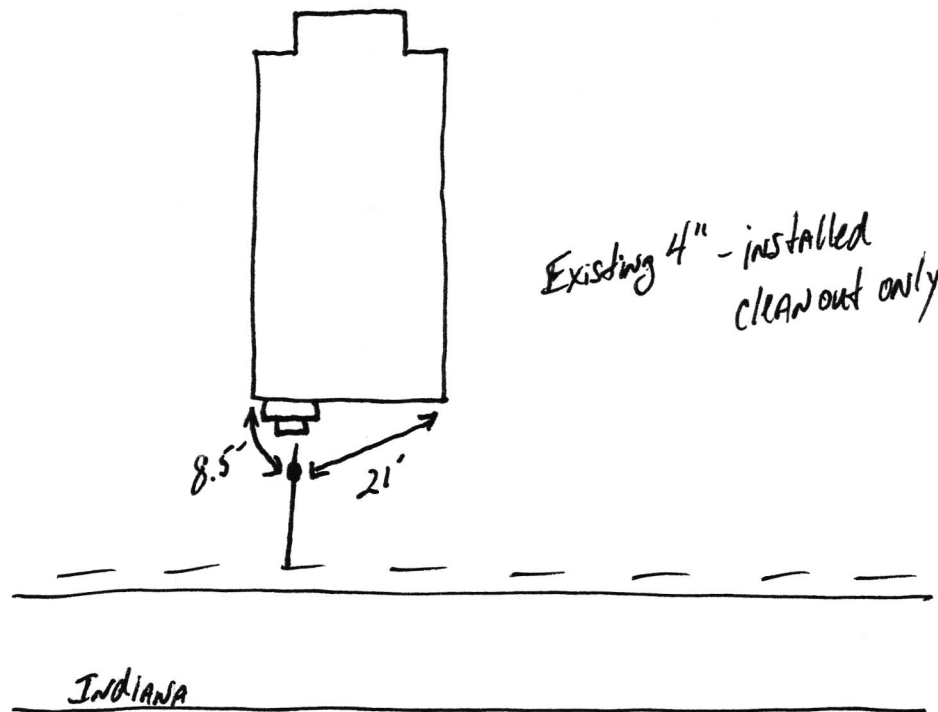

dia Indiana

S&P Phase II

6.19.18

