


Gidw.

PROJECT Phase II SHEET _____ OF _____

SUBJECT _____ DATE 4-12-18

JOB NO. 4447

BY Atlas

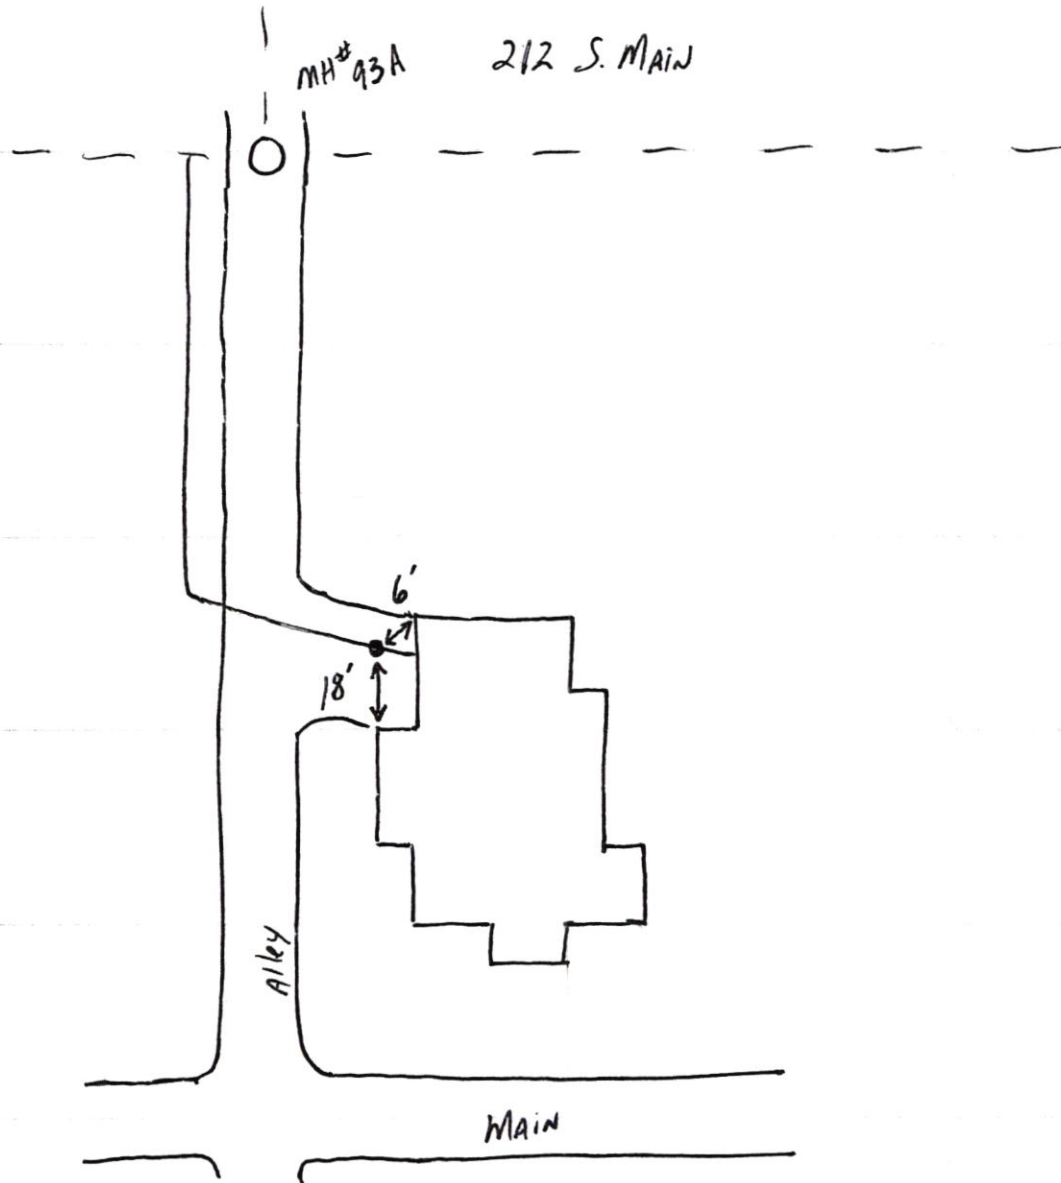

212 S Main

SRF
Phase II

4.20.18

