

GLW


PROJECT Phase II SHEET _____ OF _____

SUBJECT _____ DATE 1-26-18

JOB NO. 4447

BY Atlas

212 W. Tile

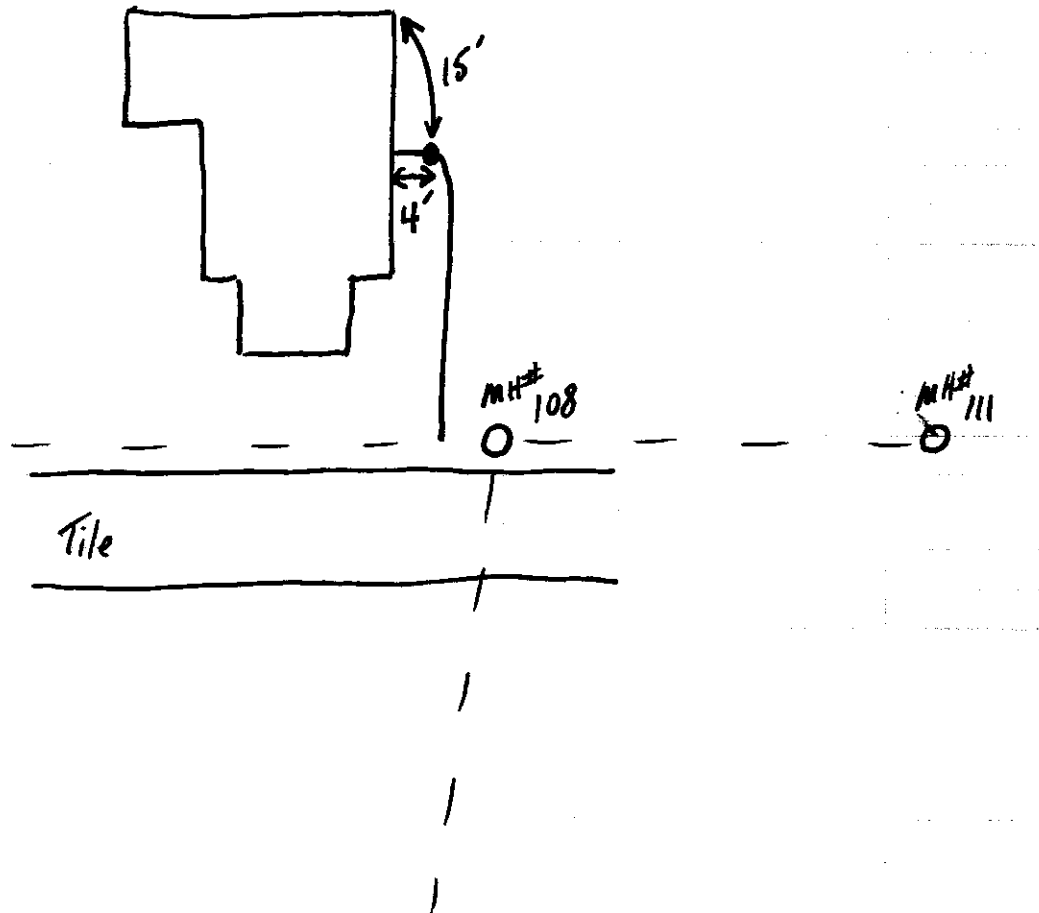

212 W Tile

SRF Phase II

1.26.18

