



FALL CREEK REGIONAL WASTE DISTRICT

9378 S. 650 West PO Box 59
Pendleton, IN 46064-0059 778-7544

APPLICATION FOR SEWER PERMIT

No. 250

Date 2/16/98

Permit Void 90 days from Date of Issuance

Owner Name Gene Brown

Property Address 212 Elm St.

Lot # _____

P.O. Box _____

Town Pendleton

IN

Zip Code 46064

Phone _____

City Water ☒

Well ☐

\$ _____ Tap on Fee Paid

\$ _____ Inspection fee paid

Application is hereby made for connection to the Fall Creek Regional Waste District Sewer System for the above listed property - Permit Type: Residential ☐, Commercial ☐, Industrial ☐, or Governmental/Institutional ☐. User Information _____.

All workmanship and materials shall conform to the standards of the District Ordinance as described in Ordinance 84-2 and 84-3 as amended. Acceptance and approval must be made by the District inspector or his duly authorized representative before backfilling and final connection is made to the main sewer lines. Any violation of applicable regulations will cause all lines and appurtenances in violation to be removed and replaced at the owners expense.

The Fall Creek Regional Waste District is responsible for the inspection, approval of materials, and installation techniques only. All costs for materials and installation and any liabilities resulting from same is the sole responsibility of the property owner.

I have read and fully understand the above provisions and agree to comply by said provisions.

APPLICANT(S) SIGNATURE _____

INSPECTOR Jim

Date inspected 2/16/98

Approved ☒

Rejected ☐

Reason for rejection _____

Date reinspected _____

Approved ☐

Rejected ☐

Notes:

Size Pipe 6"

Type Pipe SDR 35

Basement Yes ☒ No ☐

Sump Pump Yes ☐ No ☐

Downspout to Ground Yes ☒ No ☐

Septic Tank Pumped & filled Yes ☐ No ☐

Contractor Gene Brown

Special Conditions Lateral

Repair


Existing Home ☒

New Construction ☐

Gary Kelly and Mr. Brown

Share The Same Lateral

4' before entering M.H.

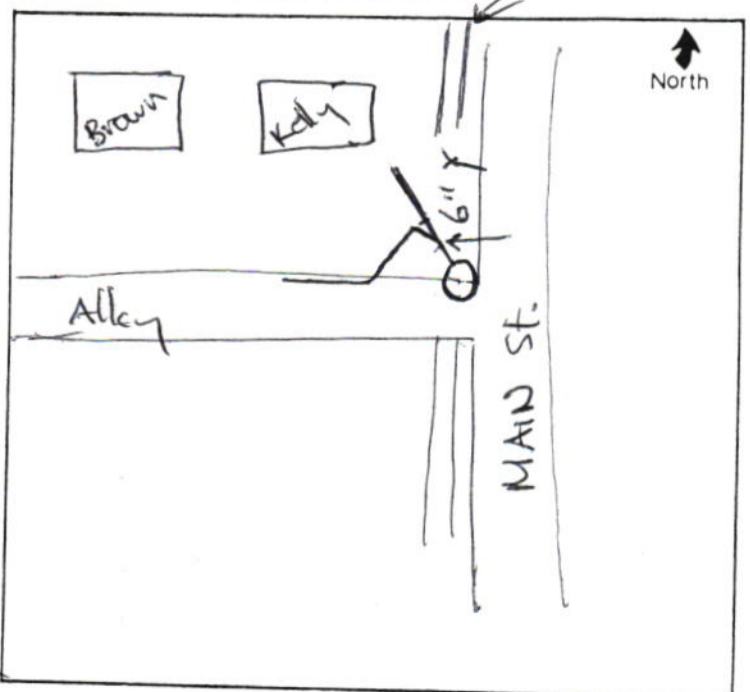

Gidw.


PROJECT Phase II SHEET _____ OF _____

SUBJECT _____ DATE 2-8-18

JOB NO. 4447

BY Atlas

212 W. Elm

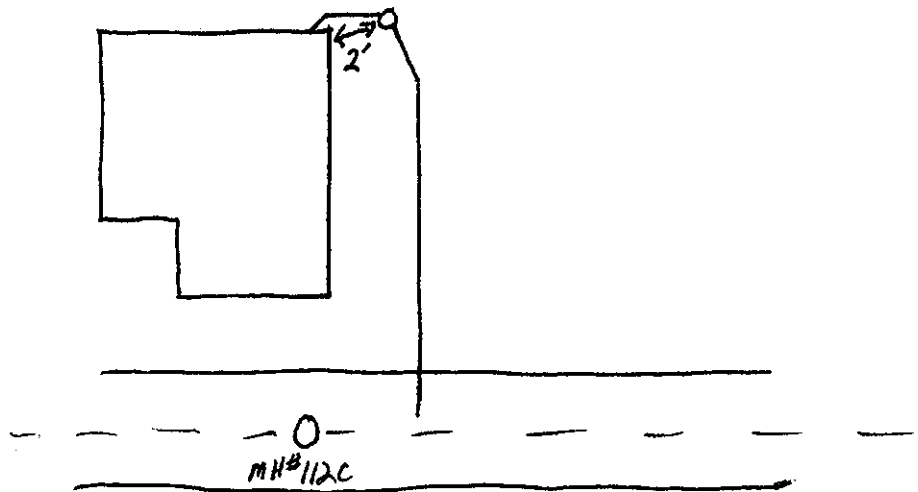

212 W Elm

SRF Phase II

2.8.18

