

Gidw.


PROJECT Phase II SHEET _____ OF _____

SUBJECT _____ DATE 4-16-18

JOB NO. 4447

BY Atlas

212 W. High

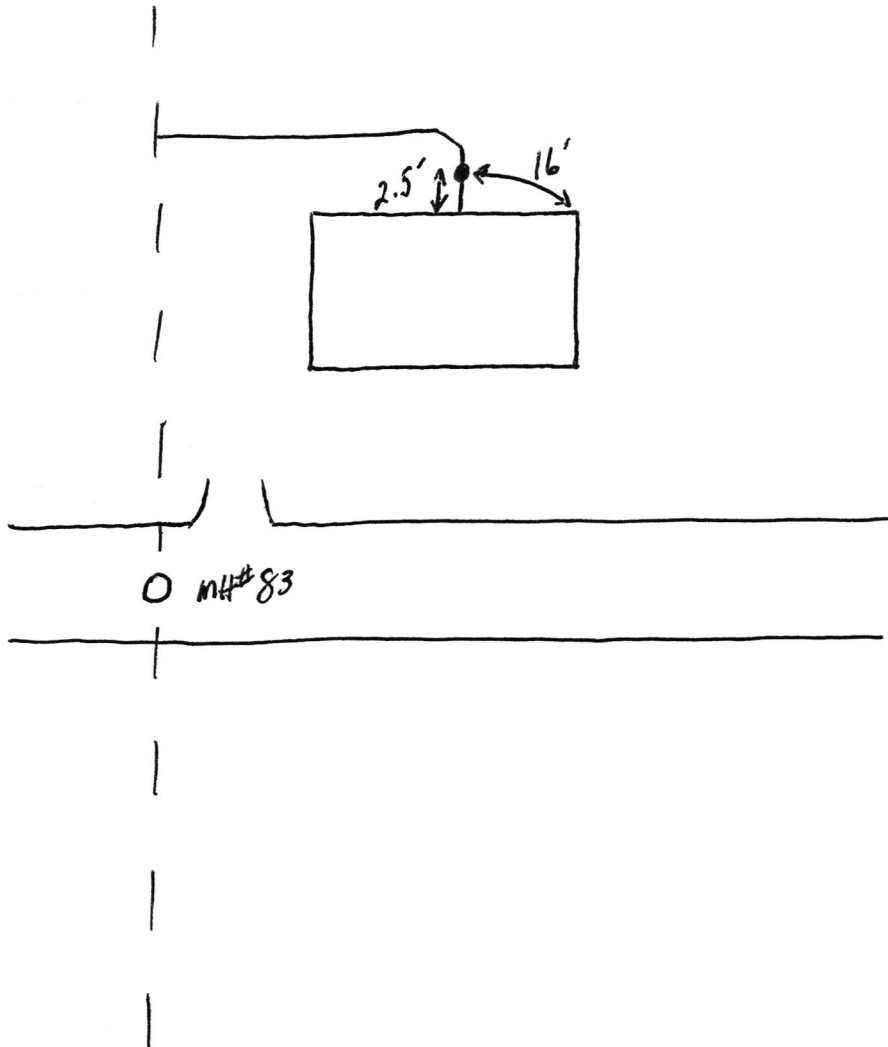

212 ~~S Adams~~
w High

SAP
Phase II

4.24.18

